
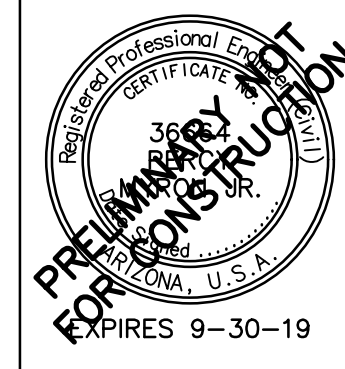


HESS - ROUNTREE, INC.
CONSULTING ENGINEERS & LAND SURVEYORS
9831 SOUTH 51ST STREET, SUITE C110
PHOENIX, ARIZONA 85044 (480)496-0244

DES. **PMJ** DRN. **JCW** CKD. **PMJ** JOB NO. **1805-03X**

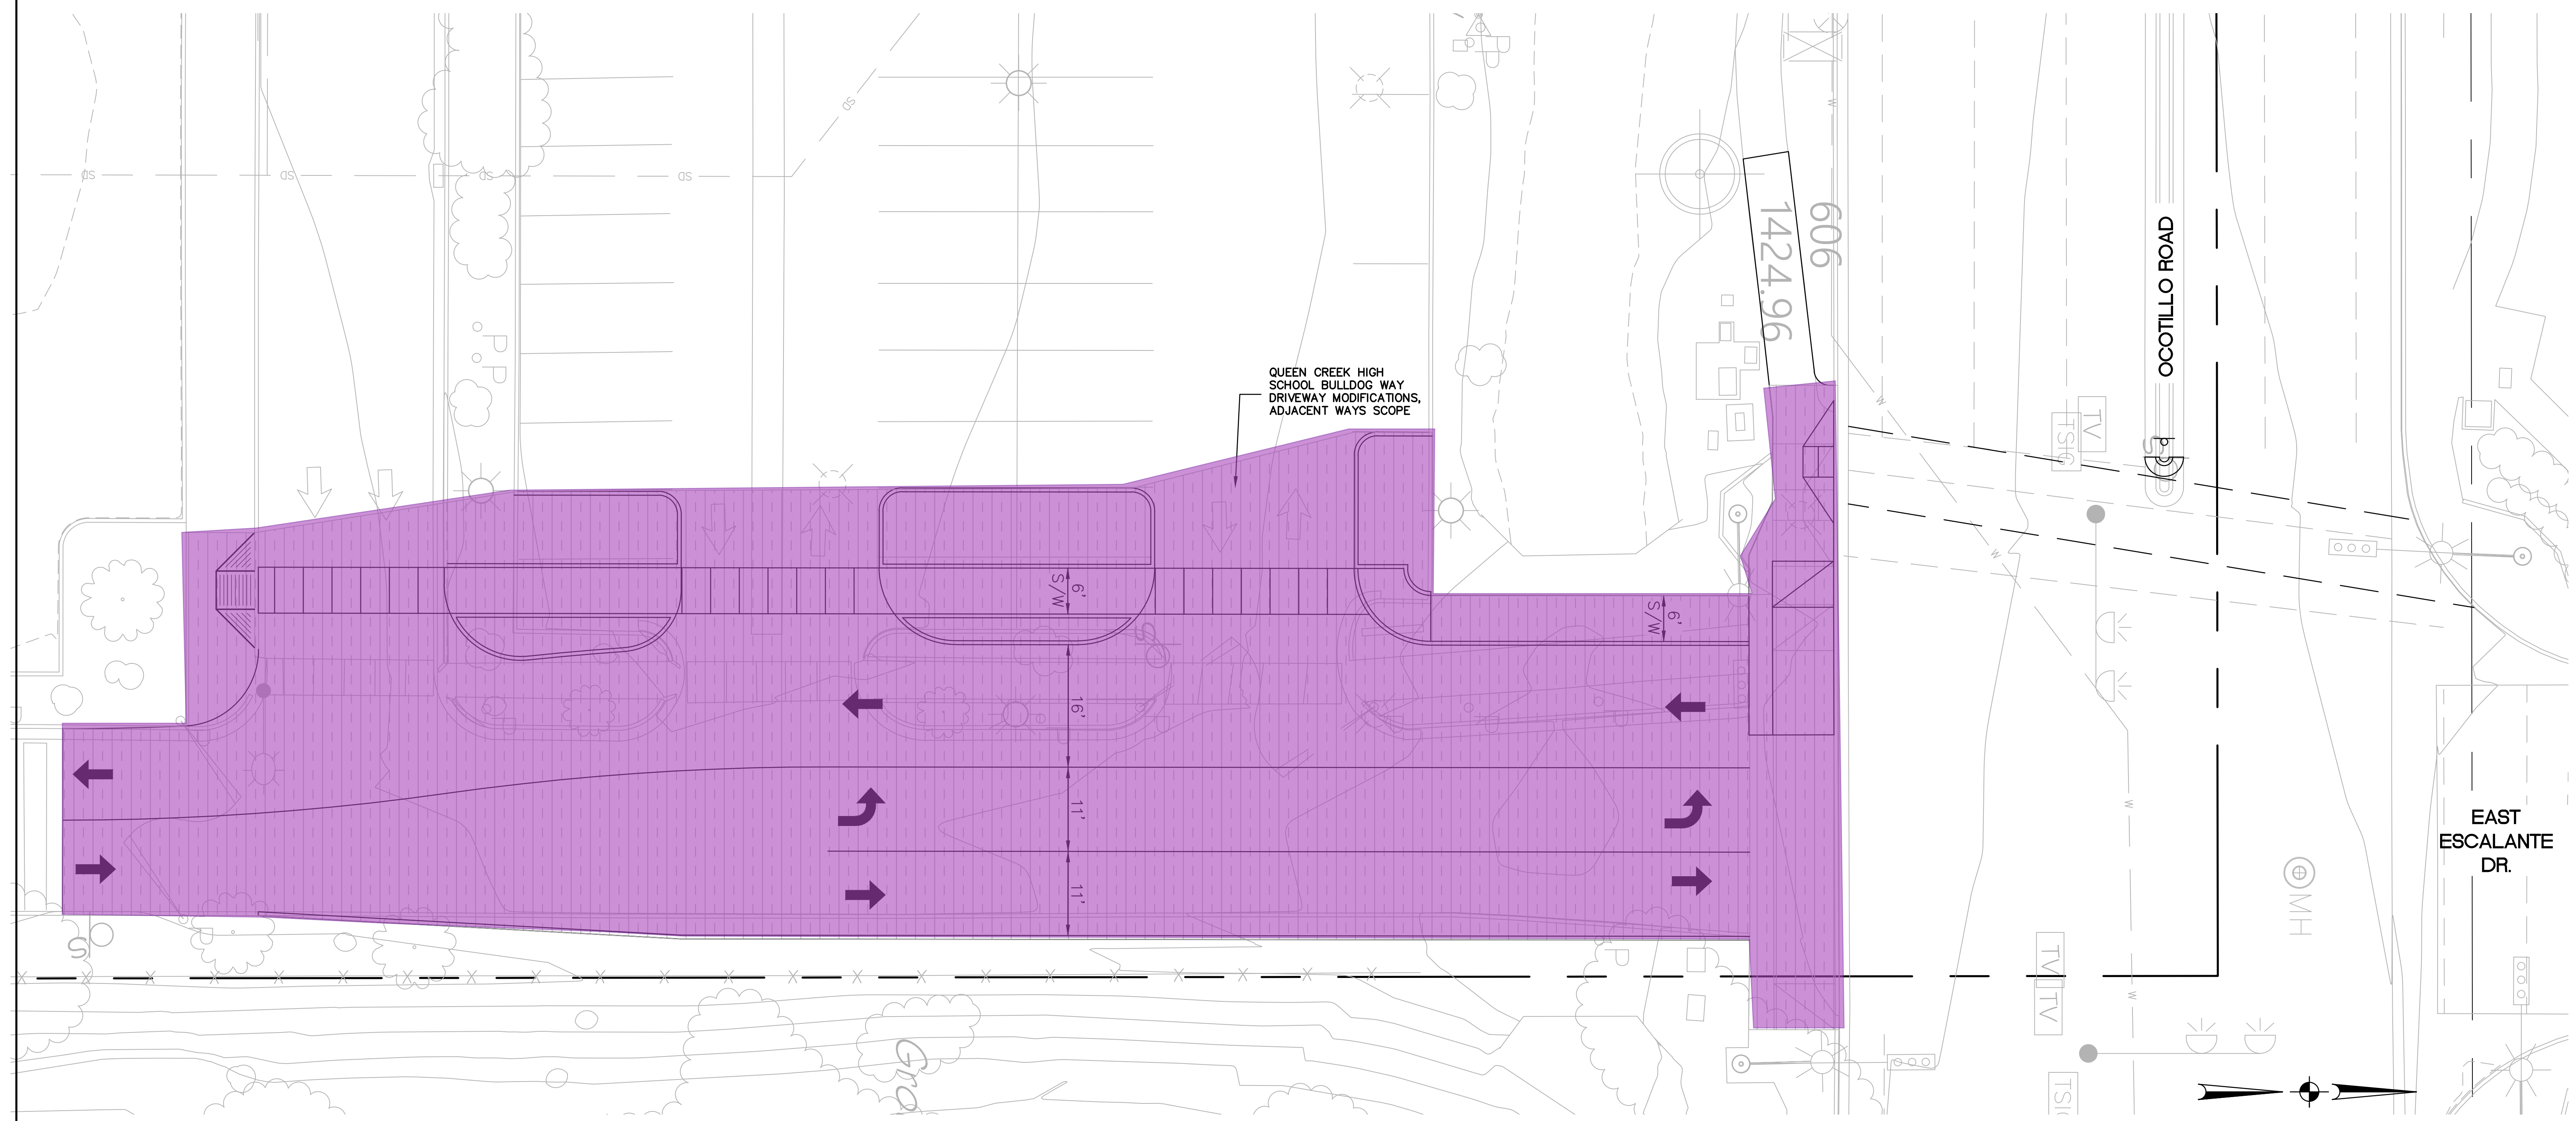

QUEEN CREEK HIGH SCHOOL BULLDOG WAY DRIVEWAY MODIFICATIONS, ADJACENT WAYS SCOPE

0 2 4 10 20
1 3 5
SCALE: 1"=10'

CALL TWO WORKING DAYS BEFORE YOU DIG
602-263-1100
1-800-STAKE-IT
(OUTSIDE MARICOPA COUNTY)

QUEEN CREEK UNIFIED SCHOOL DISTRICT #95			
QUEEN CREEK HIGH SCHOOL BULLDOG WAY DRIVEWAY MODIFICATIONS FOR QUEEN CREEK HIGH SCHOOL			
DRAWING STATUS	SHEET	OF	C-1
	1	1	
DATE: 02/28/20			

180503X1.DWG