


THIS DRAWING & THE DATA CONTAINED HEREIN ARE THE PROPERTY OF HUNT & CARAWAY ARCHITECTS, LTD. AND MAY NOT BE USED, REPRODUCED, COPIED, OR TRANSFERRED WITHOUT THE WRITTEN CONSENT OF THE PROPRIETOR AND/OR COMPANY REPRESENTATIVE. NOR SHALL ANY DATA OR INFORMATION CONTAINED HEREIN BE USED IN PART OR IN FULL FOR ANY PURPOSE OTHER THAN THAT DESCRIBED WITHIN THESE DOCUMENTS.

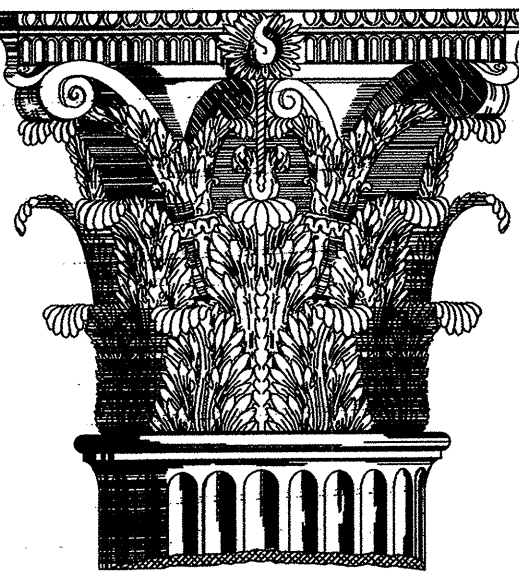

7145 North 57th Drive  
Glendale, Arizona 85301  
Voice (623) 934-4090 Fax (623) 934-4501

ASFB Project # 0704330009999010N  
CTD # 070433  
Buckeye Elementary School District #33  
DISTRICT ADDRESS:  
210 South 6th Street  
Buckeye, AZ 85326

INCA  
ELEMENTARY SCHOOL  
PROJECT ADDRESS:  
Watson Road  
Buckeye, Arizona

COMPOSITE SITE PLAN



Revisions:  
Change Car Parking 02-06-2008

Drawn by: Leo  
Checked by:  
Scale: As Shown  
Date: 05/07/07  
Issue: For Construction

**CORE**  
CONSTRUCTION  
Relationships: Subletina, Valera... Since 1977.  
3036 E. Greenway Road Phoenix, AZ 85032-4414  
RECORD DRAWINGS

JOB #  
06-021

SHEET  
**A1-1**  
SHEET 3 OF 63

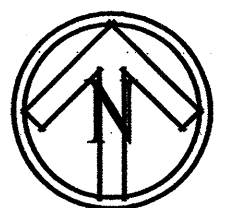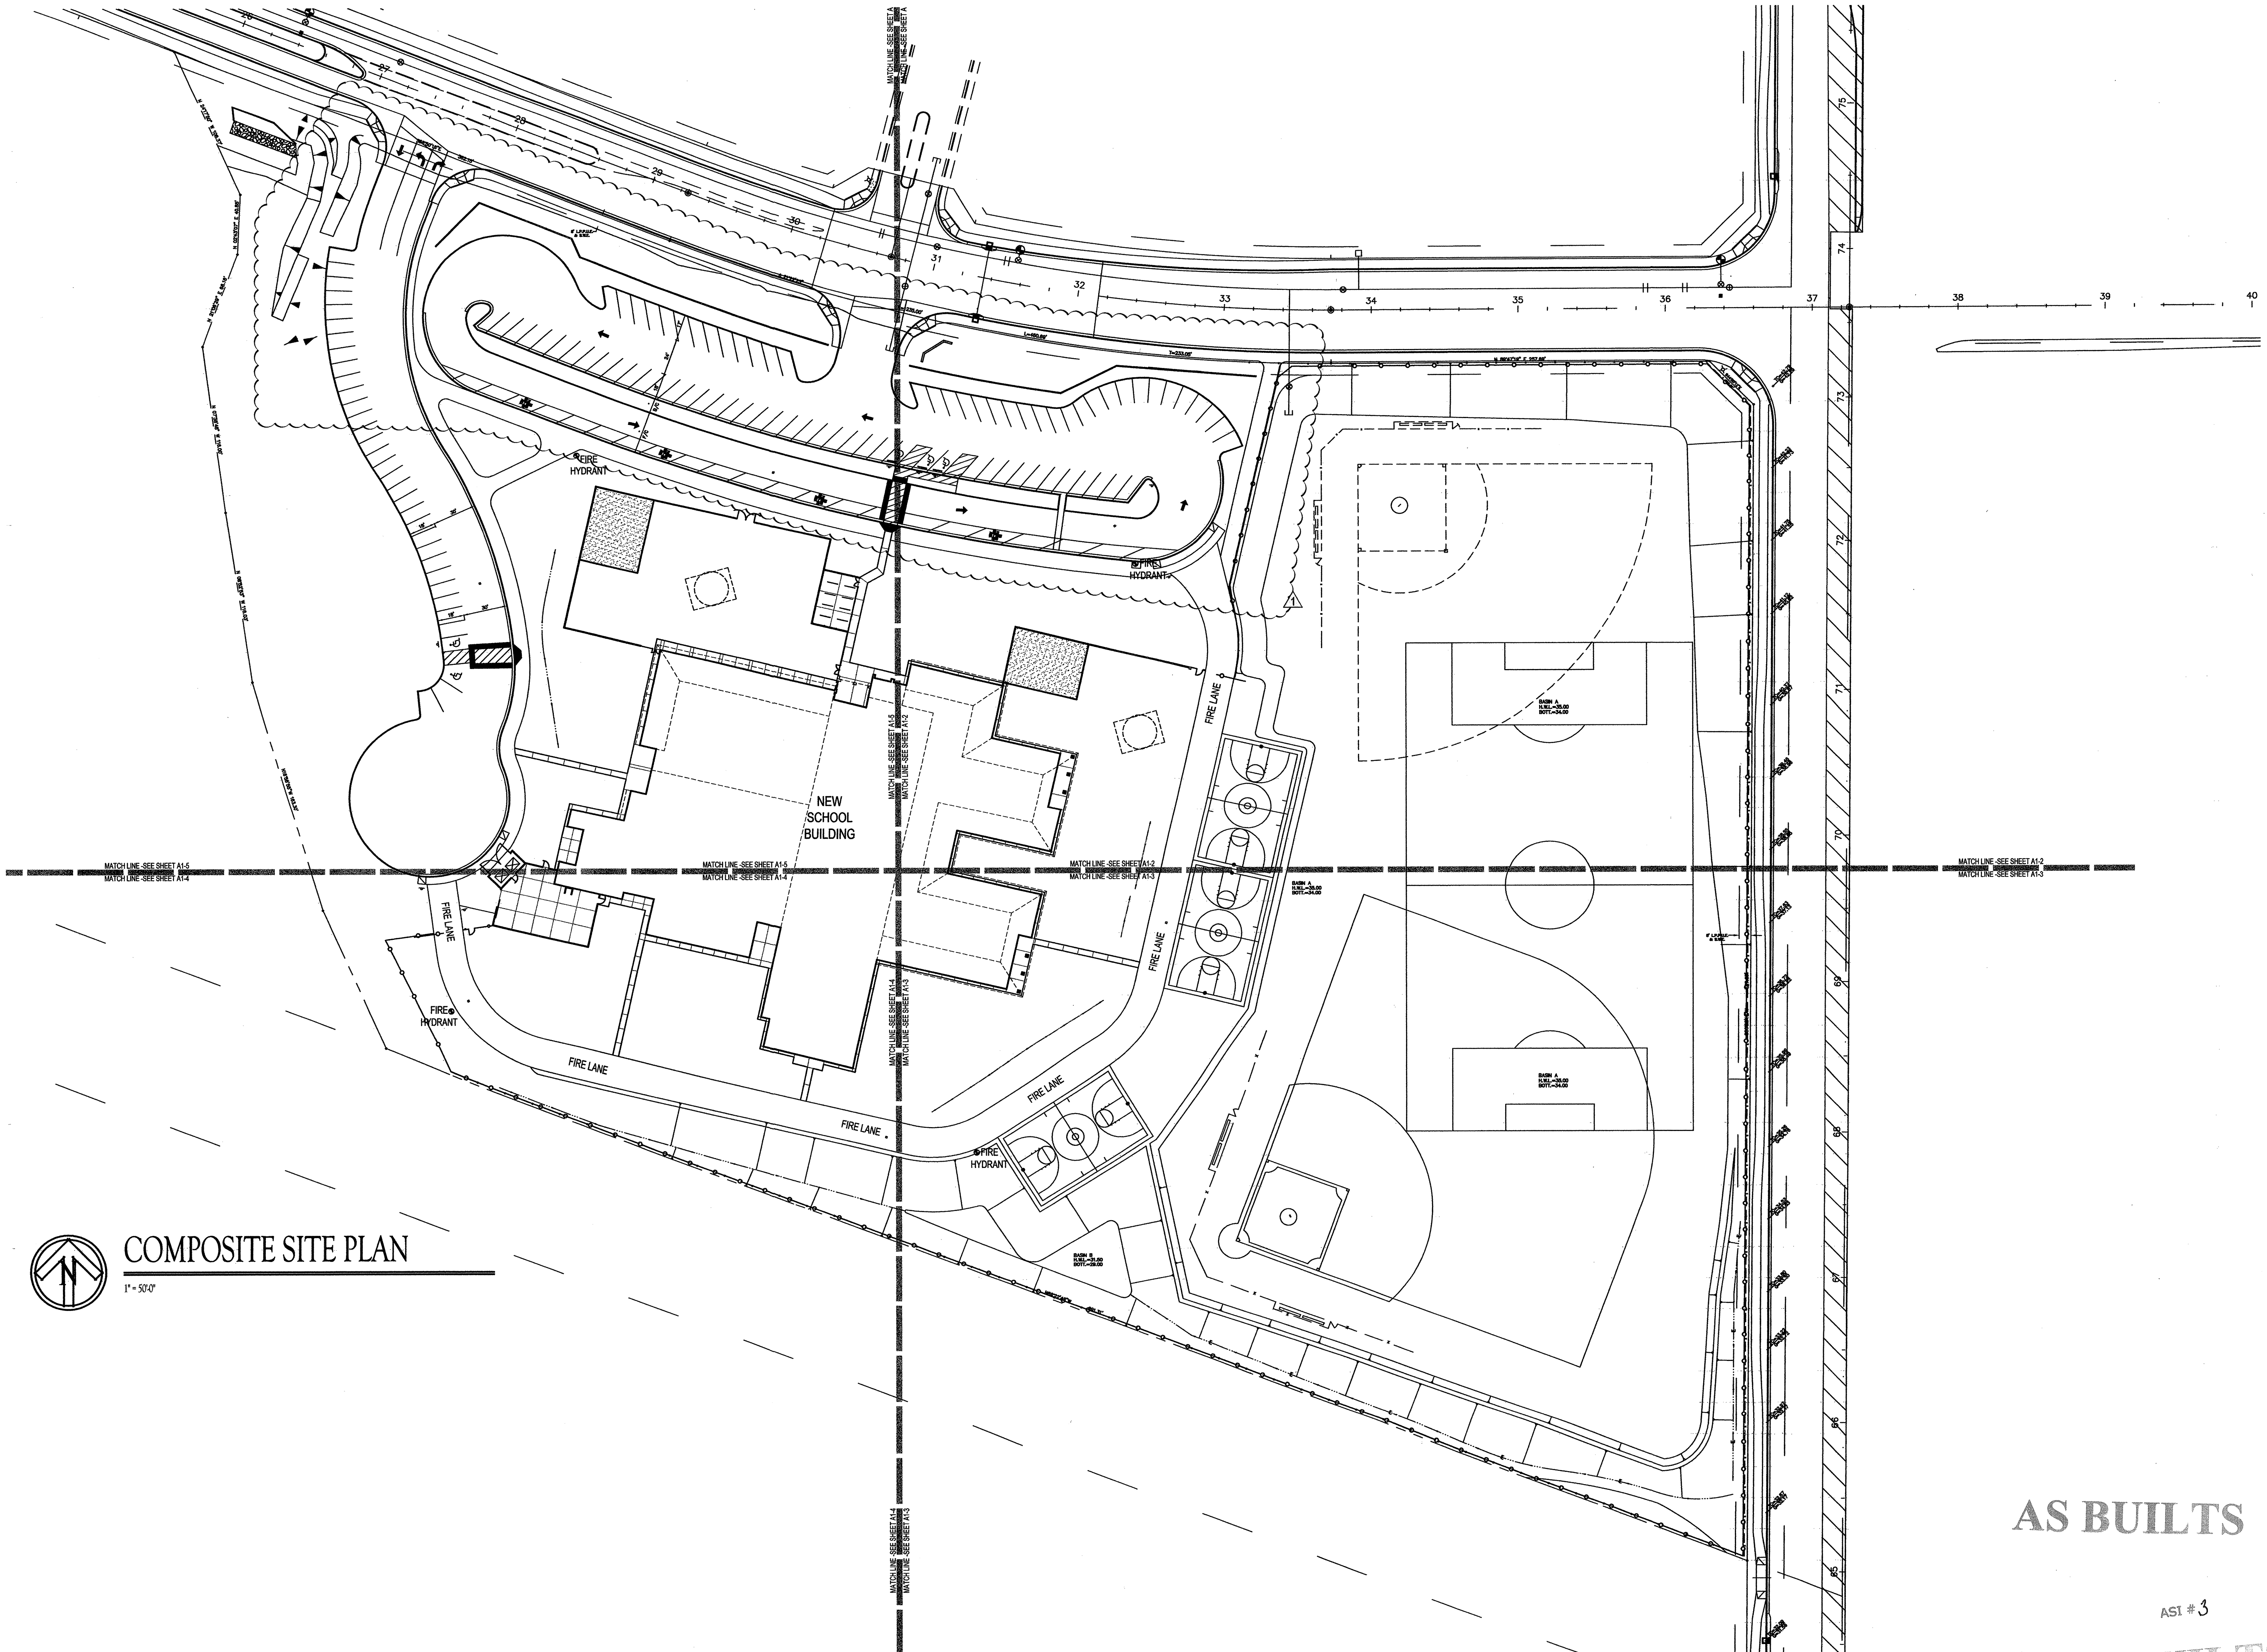

COMPOSITE SITE PLAN

1" = 50'0"

AS BUILTS

AST #3

AS BUILTS