

## CHANGE ORDER REQUEST

To:

No. COR 097R-2

Date

Project # 180046

Project Name Tolleson Union High School No 7

Project Manager Connor Lewis

### Scope Description

### Additional Days

Provide additional onsite Firelane concrete as required by regulatory agencies (AFD) and the City of Avondale's Planning and Zoning Department for Safe Access of Emergency Vehicles to the school.

Job Code	Cost Code	Description	Amount
180046-15	03100	LR Cowan- Additional Fire Lane Pavement	141,400.00
180046-15	70100	Liability Insurance	1,414.00
180046-15	70400	Builders Risk Insurance	499.85
180046-15	70500	Payment & Performance Bonds	1,576.45
180046-15	79999	Contractor Fee	7,882.03
180046-15	70600	Gross Receipts Tax	8,738.58

**Change Order Request Total** \$ 161,510.91

### NOTE:

Unless clarified above, CHASSE Building Team reserves the right to evaluate and/or revise the scheduled completion date and review general conditions for the project based on the cumulative impact of this and other changes in the future.

CONTRACTOR

OWNER

ARCHITECT

**CHASSE Building Team**

**Submitted By:**

**Approved By:**

**Approved By:**

Connor Lewis

cc:

Date:



Date:







© Copyright, YYYY, HILGARTWILSON, LLC - This plan document set is the sole property of HILGARTWILSON, LLC. No alterations to these plans, other than adding "as-built" information, are allowed by anyone other than authorized HILGARTWILSON, LLC employees.

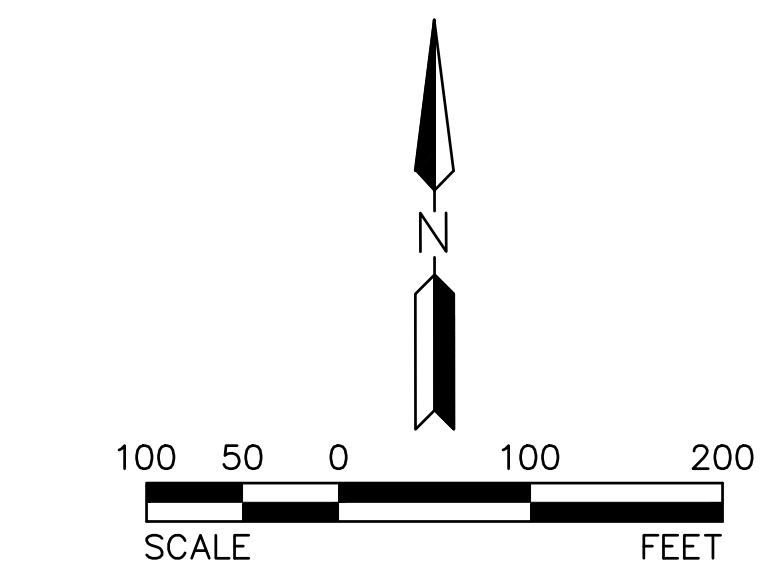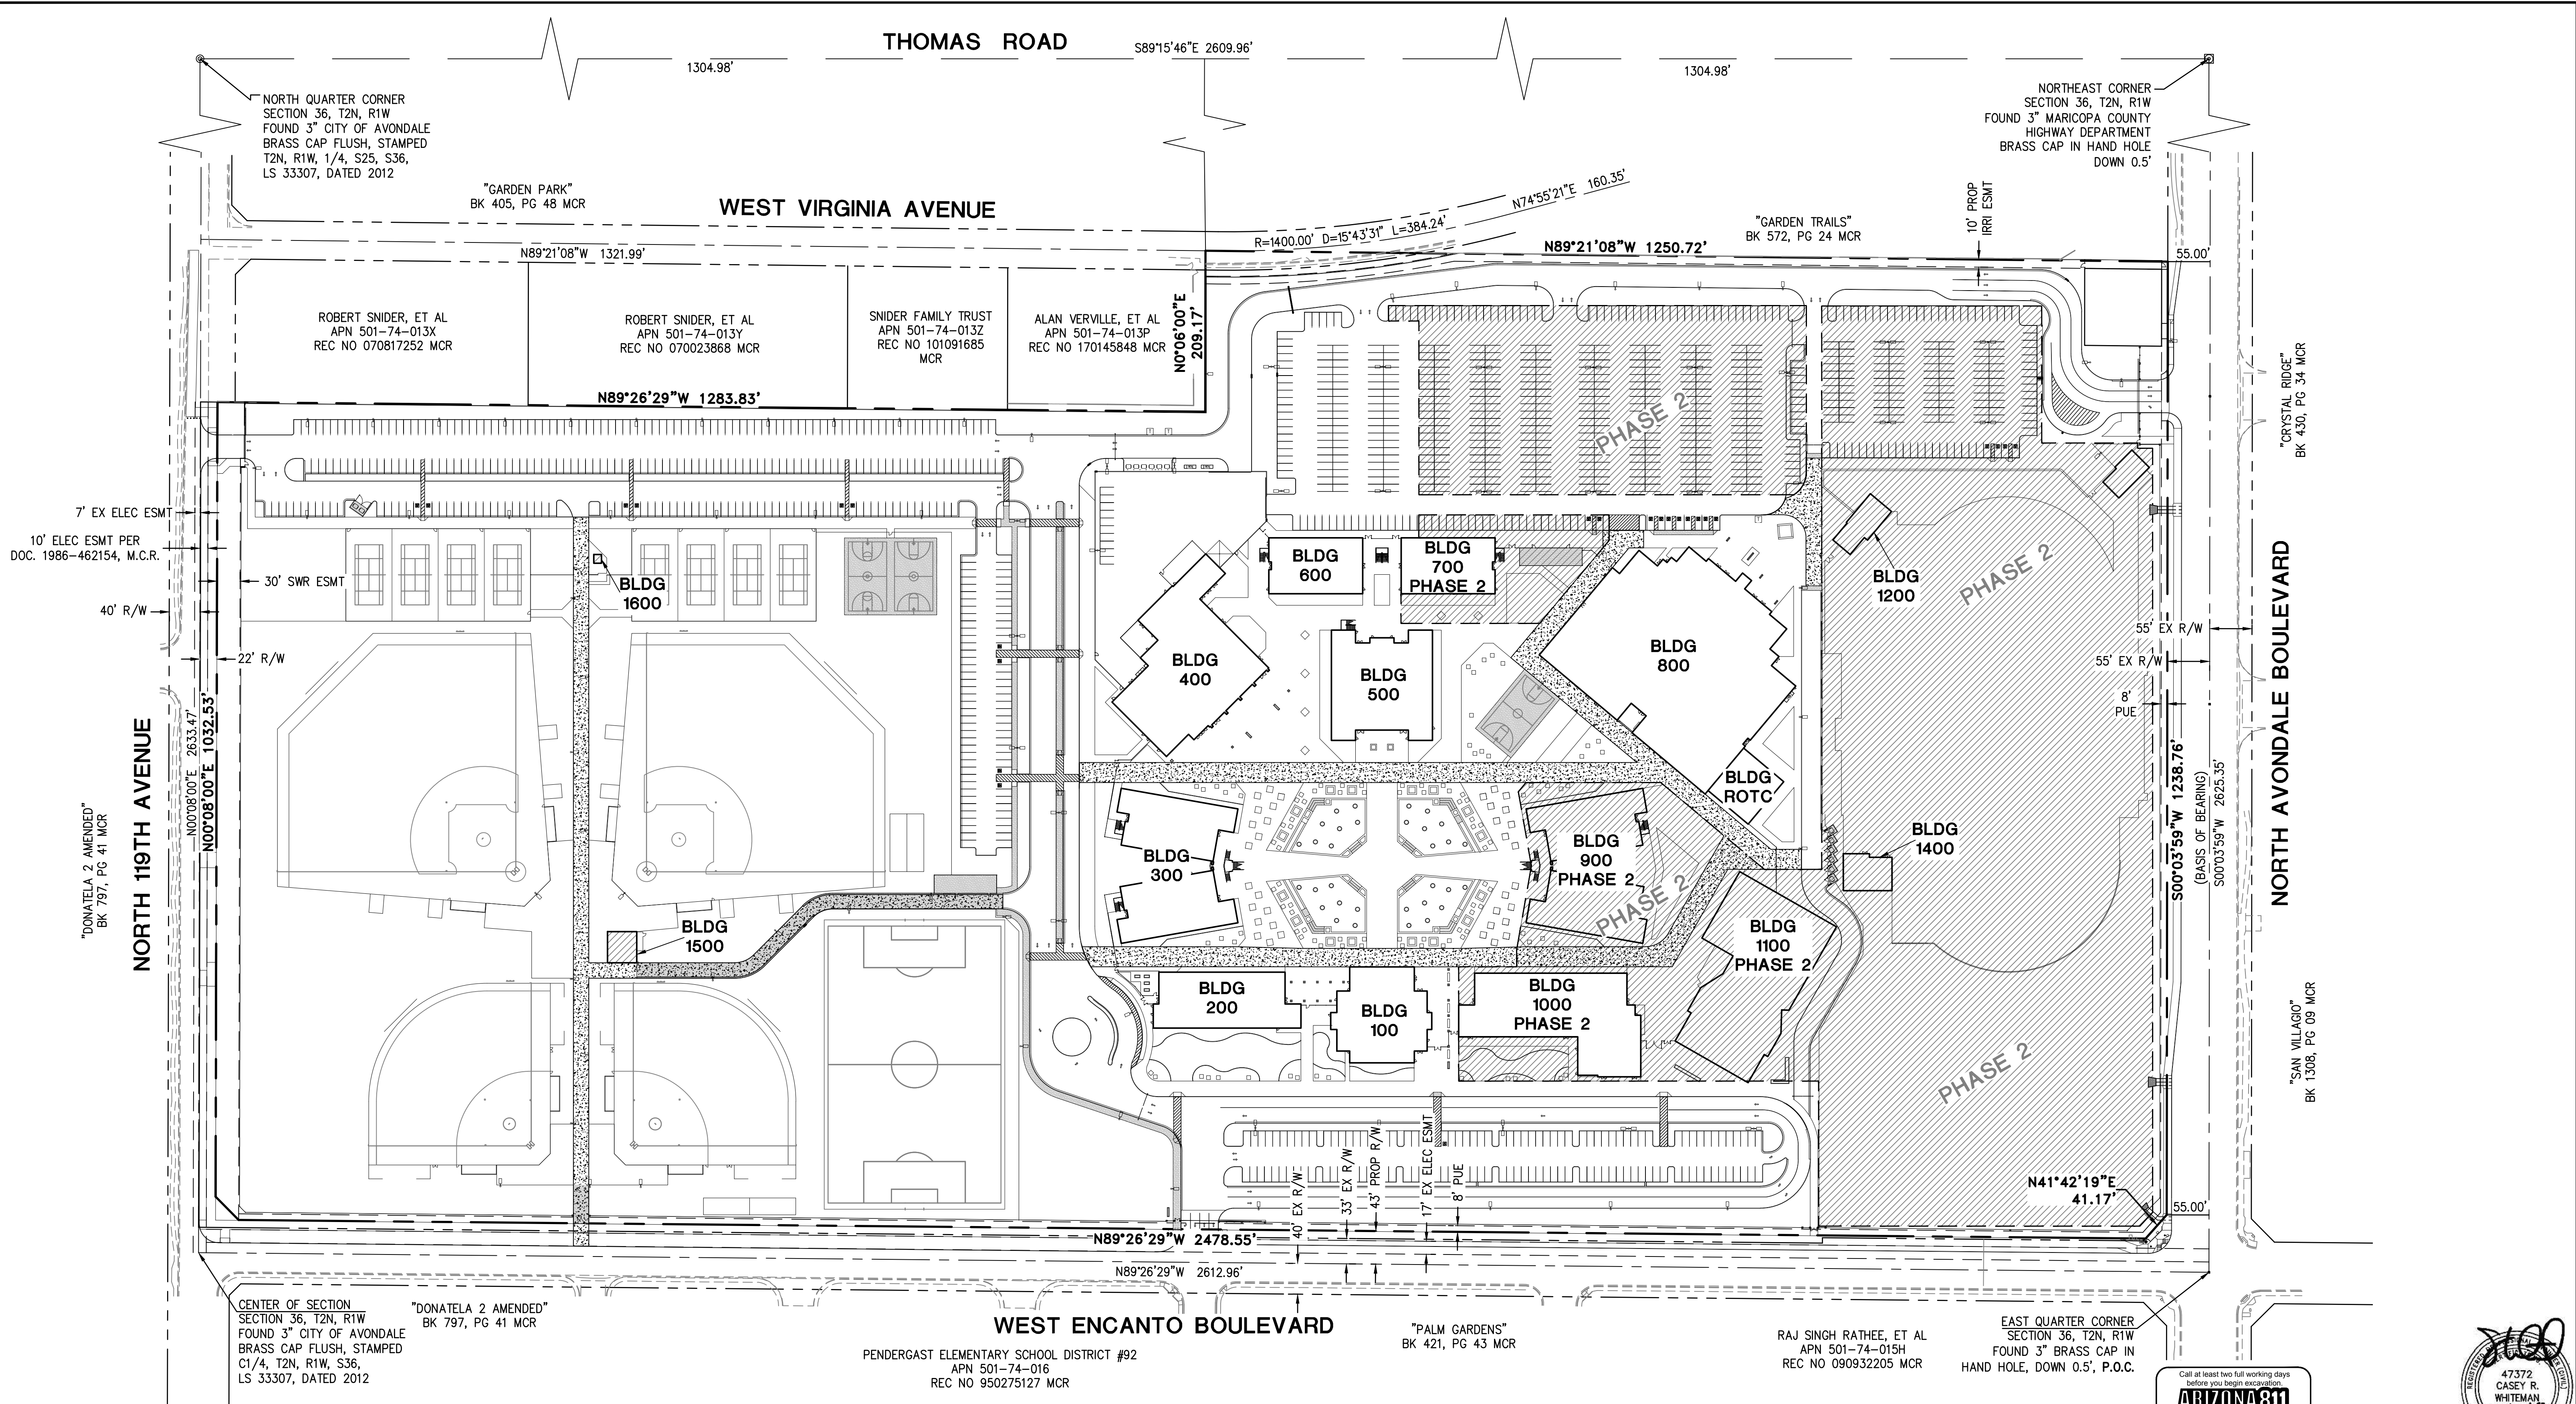

FOR REFERENCE ONLY

Call at least two full working days before you begin excavation!

**ARIZONA 811**

Arizona Blue State, Inc.


Dial 8-1-1 or 1-800-STAKE-IT (1-800-782-5348)

In Maricopa County, (602) 253-1100

47372  
CASEY R.  
WHITEMAN  
8/23/18  
ARIZONA U.S.A.  
Expire 03/31/2020

<b>TOLLESON HIGH SCHOOL #7</b>			
11620 WEST ENCANTO BLVD AVONDALE, ARIZONA			
<b>OVERALL CIVIL SITE PLAN</b>			
PROJ. NO.	1959		
DATE:	AUGUST 2018		
SCALE:	1" = 100'		
DESIGNED:	JW	DRAWN:	CM
APPROVED:	CW		
REV.			
			DWG. NO.
			<b>C1.0</b>
			SHT. X OF X

12/20/18 4:23:37 PM

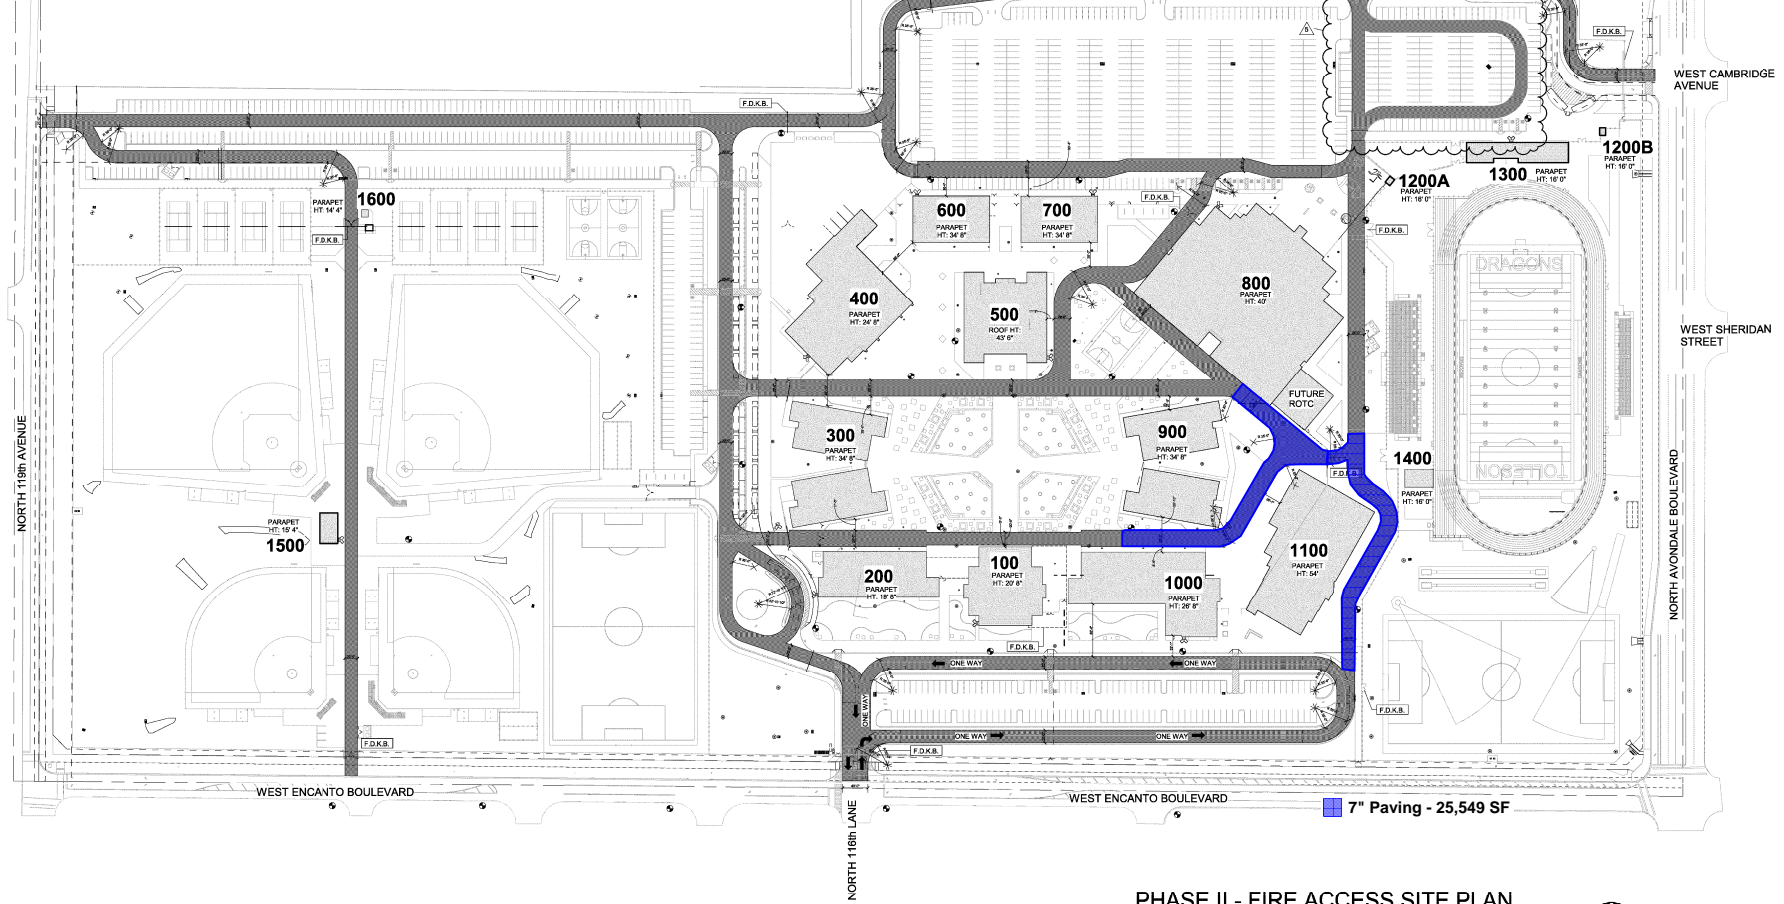

TOLLESON UNION  
HIGH SCHOOL DISTRICT  
9801 WEST VAN BUREN STREET  
TOLLESON, AZ 85383  
NEW HIGH SCHOOL #7  
PHASE II

REVISION	DATE	DESCRIPTION
1	12.04.18	CITY COMMENTS

Project Number	9802-102
Drawn	U.S.
Checked By	PM
Created By	JW

PHASE II - FIRE LANE  
ACCESS  
A0.5A.2