

Schedule of Values

revised 12/6/2016

SFB NC 600-06		NEW CONSTRUCTION SCHEDULE OF VALUES					
School District	Maricopa unified School District No.						
SFB Project Number	SFB Meeting Date:						
Architect Name	Orcutt Winslow	SD	☐				
CM @ Risk Name	Chasse Building Team	DD	☐				
County	Maricopa County	GMP	☐				
Grade Configuration	9-12						
Square Footage	122,812	enter only here	District Funded SF:				
Number of Buildings	2		Construction Schedule (number of days):				
Student Capacity	1330		Prepared by: Chris Yncera				
Acres of Land			Prepared by Company: Chasse Building Team				
Permitting (Name of County/City)							
SFB Board Approved Budget			SFB site costs (included in GMP)	\$4,487,309.00	\$0.13	AW-Y ☐	
Grand GMP			Total GMP incl. SFB, District & Adj. Ways	\$221.90		AW-N ☐	
(Total of SFB Base Cost and District Cost)		\$33,684,114.00	SFB Cost per SF	15934.92%	\$37.98	5.478520014	71.46114386
Cells to be completed - as required	Quantity	Cost per SFB Unit (no markup)	SFB Base Cost	District Cost	Other On-Site Funding (Adjacent Ways, etc.)	Off-Site Adjacent Ways	
Div 1 GENERAL CONDITIONS							
01 50 00 temporary facilities	122,812.00	\$1.75	\$215,500.00	\$99,955.00	\$13,557.00	\$290,799.00	
01 56 19 dust control	122,812.00	\$5.48	\$672,795.00	\$165,876.00	\$33,891.00	\$420,100.00	
01 57 13 track off pads	122,812.00	\$0.00					
5.68%	Division 1 total	\$0.05	\$888,295.00	\$265,831.00	\$47,448.00	\$710,899.00	
Div 2 EXISTING CONDITIONS							
02 21 13 survey	122,812.00	\$0.29	\$35,597.00		\$5,000.00	\$65,518.00	
02 41 13 site demolition/removal	122,812.00	\$0.45	\$55,449.00		\$12,827.00	\$60,586.00	
02 60 00 soil treatment	122,812.00	\$0.00					
0.70%	Division 2 total	\$0.01	\$91,046.00	\$0.00	\$17,827.00	\$126,104.00	
Div 3 CONCRETE							
03 00 00 footings/walls	122,812.00	\$11.25	\$1,381,064.00	\$42,910.00			
03 00 00 building	122,812.00	\$0.00					
03 20 00 rebar	122,812.00	\$0.00					
03 30 53 slabs	122,812.00	\$0.00					
03 35 00 sealed floors	122,812.00	\$0.00					
03 40 00 precast concrete	122,812.00	\$0.00					
4.23%	Division 3 total	\$0.09	\$1,381,064.00	\$42,910.00	\$0.00	\$0.00	
Div 4 MASONRY							
04 00 00 masonry walls	122,812.00	\$5.68	\$697,122.00	\$602,400.00			
04 00 00 masonry columns	122,812.00	\$0.00					
04 05 19 rebar	122,812.00	\$0.00					
04 22 00 site masonry	122,812.00	\$0.00					
04 22 00 block fencing	122,812.00	\$0.00					
04 43 00 stonework	122,812.00	\$0.00					
3.86%	Division 4 total	\$0.04	\$697,122.00	\$602,400.00	\$0.00	\$0.00	
Div 5 METALS							
05 00 00 miscellaneous steel	122,812.00	\$11.27	\$1,383,500.00	\$323,563.00			
05 10 00 structural steel	122,812.00	\$0.00					
05 30 00 metal decking	122,812.00	\$0.00					
05 51 00 stairs	122,812.00	\$0.00					
05 70 00 architectural steel	122,812.00	\$0.00					
5.07%	Division 5 total	\$0.09	\$1,383,500.00	\$323,563.00	\$0.00	\$0.00	
Div 6 WOODS/PLASTICS/COMPOSITES							
06 10 00 rough carpentry structure	122,812.00	\$8.42	\$1,033,602.00				
06 15 00 wood decking	122,812.00	\$0.00					
06 20 00 finish carpentry	122,812.00	\$0.00					
06 40 00 millwork/casework	122,812.00	\$1.35	\$166,253.00	\$69,308.00			
06 60 00 plastic/glass fiber	122,812.00	\$0.00					
3.77%	Division 6 total	\$0.07	\$1,199,855.00	\$69,308.00	\$0.00	\$0.00	

Schedule of Values

revised 12/6/2016

			SFB Cost per SF	15934.92%	\$37.98	5.478520014	71.46114386
			Cost per				
	Cells to be completed - as required		SFB Unit	SFB	District	Other On-Site	Off-Site
		Quantity	(no markup)	Base Cost	Cost	Funding (Adjacent Ways, etc.)	Adjacent Ways
Div 7	THERMAL/MOISTURE						
07 10 00	waterproofing/dampproofing	122,812.00	\$0.00				
07 20 00	building insulation	122,812.00	\$0.50	\$61,596.00			
07 21 00	foam roof	122,812.00	\$0.00				
07 25 00	weather barrier	122,812.00	\$0.00				
07 31 00	roof shingles	122,812.00	\$0.00				
07 32 00	roof tiles	122,812.00	\$0.00				
07 50 00	membrane roofing	122,812.00	\$5.94	\$729,410.00			
07 60 00	metal roof	122,812.00	\$0.00				
07 60 00	general sheet metal	122,812.00	\$0.39	\$48,345.00			
07 72 00	roof accessories	122,812.00	\$0.00				
07 81 00	sprayed fireproofing	122,812.00	\$0.00				
07 84 00	firestopping	122,812.00	\$0.00				
07 95 00	roof expansion joint	122,812.00	\$0.00				
07 92 00	joint sealants	122,812.00	\$0.56	\$68,262.00			\$6,437.00
2.71%	Division 7 total		\$0.06	\$907,613.00	\$0.00	\$0.00	\$6,437.00
Div 8	OPENINGS						
81 10 00	doors & frames	122,812.00	\$4.42	\$543,000.00	\$12,500.00		
08 33 00	overhead doors	122,812.00	\$0.38	\$46,645.00			
08 40 00	storefronts	122,812.00	\$0.00				
08 44 00	curtain walls	122,812.00	\$0.00				
08 50 00	windows	122,812.00	\$1.36	\$166,716.00			
08 60 00	skylights	122,812.00	\$0.00				
08 70 00	hardware	122,812.00	\$0.00				
08 71 13	automatic doors	122,812.00	\$0.00				
08 79 00	knox box	122,812.00	\$0.00				
08 80 00	glass & glazing	122,812.00	\$0.00				
2.28%	Division 8 total		\$0.05	\$756,361.00	\$12,500.00	\$0.00	\$0.00
Div 9	FINISHES						
09 24 00	stucco/EIFS systems	122,812.00	\$0.22	\$27,000.00			
09 20 00	interior metal studs/gypsum board	122,812.00	\$6.36	\$780,476.00	\$41,155.00		
09 22 00	exterior metal stud framing	122,812.00	\$0.00				
09 23 00	decorative plaster	122,812.00	\$0.00				
09 51 00	acoustical ceilings	122,812.00	\$1.90	\$233,012.00	\$66,048.00		
09 31 00	ceramic tile	122,812.00	\$0.46	\$56,926.00	\$162,753.00		
09 65 00	resilient flooring	122,812.00	\$0.00				
09 68 00	carpet	122,812.00	\$0.57	\$70,035.00	\$573,095.00		
09 64 00	wood floors	122,812.00	\$0.00				
09 67 00	epoxy	122,812.00	\$0.00				
09 80 00	sound panels	122,812.00	\$0.00				
09 90 00	painting	122,812.00	\$1.55	\$189,882.00	\$24,900.00		
09 77 00	fiberglass reinforced panels	122,812.00	\$0.00				
6.61%	Division 9 total		\$0.08	\$1,357,331.00	\$867,951.00	\$0.00	\$0.00
Div 10	SPECIALTIES						
10 11 00	visual display boards	122,812.00	\$0.00				
10 14 00	signage	122,812.00	\$0.46	\$56,830.00			
10 21 13	toilet partitions & accessories	122,812.00	\$1.06	\$129,782.00	\$85,925.00		
10 21 23	cubicle track & curtain	122,812.00	\$0.00				
10 22 26	operable partitions/walls	122,812.00	\$0.00				
10 26 00	wall protection	122,812.00	\$0.00				
10 44 00	fire extinguishers & cabinets	122,812.00	\$0.00				
10 50 00	lockers	122,812.00	\$0.00				
10 56 13	storage shelving	122,812.00	\$0.00				
10 73 00	shelters	122,812.00	\$0.00				
10 73 13	awnings	122,812.00	\$0.00				
10 73 13	canopy/ramada	122,812.00	\$0.00				
10 75 00	flagpoles	122,812.00	\$0.00				
0.81%	Division 10 total		\$0.01	\$186,612.00	\$85,925.00	\$0.00	\$0.00

Schedule of Values

revised 12/6/2016

			SFB Cost per SF	15934.92%	\$37.98	5.478520014	71.46114386
			Cost per				
	Cells to be completed - as required	Quantity	SFB Unit (no markup)	SFB Base Cost	District Cost	Other On-Site Funding (Adjacent Ways, etc.)	Off-Site Adjacent Ways
Div 11	EQUIPMENT						
11 16 16	floor safe	122,812.00	\$0.00				
11 41 00	kitchen equipment	122,812.00	\$0.77	\$95,037.00	\$358,768.00		
11 51 00	library equipment	122,812.00	\$0.00				
11 52 00	audio/visual equipment	122,812.00	\$0.00				
11 52 13	projection screens	122,812.00	\$0.00				
11 53 13	fume hoods	122,812.00	\$0.00				
11 61 43	stage curtain/equipment	122,812.00	\$0.00				
11 66 00	sports/PE equipment	122,812.00	\$0.93	\$113,880.00	\$139,499.00		
11 68 00	playground equipment	122,812.00	\$0.00				
11 68 23	site basketball courts	122,812.00	\$0.00				
11 68 33	ballfield backstop	122,812.00	\$0.00				
11 68 33	sports fields	122,812.00	\$0.00				
2.10%	Division 11 total		\$0.01	\$208,917.00	\$498,267.00	\$0.00	\$0.00
Div 12	FURNISHINGS						
12 20 00	window coverings	122,812.00	\$0.00				
12 31 00	metal casework	122,812.00	\$0.00				
12 32 16	plastic laminate casework	122,812.00	\$0.00				
12 61 00	auditorium seating	122,812.00	\$0.00				
12 93 13	bike racks	122,812.00	\$0.00				
12 93 23	trash enclosures	122,812.00	\$0.00				
0.00%	Division 12 total		\$0.00	\$0.00	\$0.00	\$0.00	\$0.00
Div 13	SPECIAL CONST						
13 00 00	equipment/storage enclosures	122,812.00	\$0.00				
13 11 00	swimming pools	122,812.00	\$0.00				
13 34 16	bleachers	122,812.00	\$0.00				
13 34 19	metal buildings	122,812.00	\$0.00				
0.00%	Division 13 total		\$0.00	\$0.00	\$0.00	\$0.00	\$0.00
Div 14	CONVEYING						
14 00 00	material handling	122,812.00	\$0.00				
14 20 00	elevators	122,812.00	\$0.65	\$79,525.00			
14 42 00	wheelchair lifts	122,812.00	\$0.00				
0.24%	Division 14 total		\$0.00	\$79,525.00	\$0.00	\$0.00	\$0.00
Div 21	FIRE SUPPRESSION						
21 10 00	fire protection/sprinklers	122,812.00	\$2.35	\$289,084.00			
0.86%	Division 21 total		\$0.02	\$289,084.00	\$0.00	\$0.00	\$0.00
Div 22	PLUMBING						
22 11 00	supply piping	122,812.00	\$7.21	\$885,138.00	\$277,488.00		
22 13 00	waste water piping	122,812.00	\$0.00				
22 31 00	water treatment (softner)	122,812.00	\$0.00				
22 32 00	water treatment (filtered)	122,812.00	\$0.00				
22 35 00	water heaters	122,812.00	\$0.00				
22 42 00	plumbing fixtures	122,812.00	\$0.00				
3.45%	Division 22 total		\$0.05	\$885,138.00	\$277,488.00	\$0.00	\$0.00
Div 23	MECHANICAL						
23 07 13	mechanical insulation	122,812.00	\$17.01	\$2,088,503.00	\$94,820.00		
23 50 00	HVAC - central plant (cooling)	122,812.00	\$0.00				
23 60 00	HVAC - central plant (heating)	122,812.00	\$0.00				
23 76 00	HVAC - evaporative	122,812.00	\$0.00				
23 80 00	HVAC - package units	122,812.00	\$0.00				
23 81 26	HVAC - split system	122,812.00	\$0.00				
6.48%	Division 23 total		\$0.13	\$2,088,503.00	\$94,820.00	\$0.00	\$0.00
Div 25	INTEGRATED AUTOMATION						
25 50 00	EMS	122,812.00	\$0.00				
0.00%	Division 25 total		\$0.00	\$0.00	\$0.00	\$0.00	\$0.00
Div 26	ELECTRICAL						
26 10 00	site electrical	122,812.00	\$15.98	\$1,962,874.00	\$64,324.00		\$805,117.00
26 10 00	electrical	122,812.00	\$0.00				
26 30 00	generators	122,812.00	\$0.00				
26 56 00	exterior lighting	122,812.00	\$0.00				
8.41%	Division 26 total		\$0.12	\$1,962,874.00	\$64,324.00	\$0.00	\$805,117.00
Div 27	COMMUNICATIONS						
27 20 00	data cabling	122,812.00	\$0.00				
27 24 00	TV cabling	122,812.00	\$0.00				
27 30 00	intercom	122,812.00	\$0.00				
27 32 13	communications/phone	122,812.00	\$0.00				
0.00%	Division 27 total		\$0.00	\$0.00	\$0.00	\$0.00	\$0.00

Schedule of Values

revised 12/6/2016

			SFB Cost per SF	15934.92%	\$37.98	5.478520014	71.46114386
			Cost per			Other On-Site	
	Cells to be completed - as required		SFB Unit	SFB	District	Funding	Off-Site
		Quantity	(no markup)	Base Cost	Cost	(Adjacent Ways, etc.)	Adjacent Ways
Div 28	SAFETY AND SECURITY						
28 10 00	security system	122,812.00	\$0.00				
28 20 00	surveillance/alarm	122,812.00	\$0.00				
28 31 00	fire alarm system	122,812.00	\$2.26	\$277,191.00			
0.82%	Division 28 total		\$0.02	\$277,191.00	\$0.00	\$0.00	\$0.00
Div 31	EARTHWORK						
31 23 00	earthwork/mass excavation	122,812.00	\$5.25	\$645,321.00	\$54,811.00	\$101,670.00	\$994,636.00
31 23 00	import/export dirt	122,812.00	\$0.00				
31 31 00	soil treatment - termite	122,812.00	\$0.04	\$5,146.00			
5.35%	Division 31 total		\$0.04	\$650,467.00	\$54,811.00	\$101,670.00	\$994,636.00
Div 32	EXTERIOR IMPROVEMENTS						
32 00 00	parking	122,812.00	\$0.00				
32 00 00	unusal site conditions	122,812.00	\$0.00				
32 10 00	asphalt/paving	122,812.00	\$0.00			\$241,500.00	\$281,000.00
32 13 00	site concrete	122,812.00	\$0.00			\$121,373.00	\$241,447.00
32 13 00	sidewalks	122,812.00	\$0.00			\$17,255.00	\$85,000.00
32 17 00	striping/signage	122,812.00	\$0.00			\$5,000.00	\$25,000.00
32 31 13	chainlink fencing	122,812.00	\$0.02	\$2,250.00	\$153,374.00		
32 31 19	wrought iron fencing	122,812.00	\$0.00				
32 32 00	retaining walls	122,812.00	\$0.00				
32 80 00	irrigation	122,812.00	\$0.00				
32 90 00	landscaping	122,812.00	\$1.61	\$197,190.00	\$372,835.00		\$10,689.00
5.21%	Division 32 total		\$0.01	\$199,440.00	\$526,209.00	\$385,128.00	\$643,136.00
Div 33	UTILITIES						
33 00 00	site utilities	122,812.00	\$5.24	\$643,036.00			\$3,993,853.00
33 21 00	wells	122,812.00	\$0.00				
33 32 16	lift station	122,812.00	\$0.00				
33 36 00	septic system	122,812.00	\$0.00				
33 40 00	stormwater/drainage	122,812.00	\$0.00				
33 49 23	drywells	122,812.00	\$0.42	\$52,151.00			
13.92%	Division 33 total		\$0.04	\$695,187.00	\$0.00	\$0.00	\$3,993,853.00
	Subtotal	\$27,803,687.00		\$16,185,125.00	\$3,786,307.00	\$552,073.00	\$7,280,182.00
1.795E-09	Contractor Fee		6.05%	\$978,500.00	\$233,250.00	\$33,891.00	\$420,100.00
8.727E-10	Contactor Contingency		2.94%	\$475,795.00	\$185,240.00	\$19,996.00	\$247,147.00
\$0.00	Builders Risk/Liability Insurance		2.19%	\$354,217.00	\$84,437.00	\$12,269.00	\$152,076.00
\$0.00	Performance & Payment Bonds		1.33%	\$215,270.00	\$51,315.00	\$7,456.00	\$92,422.00
2.497E-09	Sales Tax		8.41%	\$1,361,093.00	\$324,451.00	\$47,143.00	\$584,359.00
	Subtotal	\$33,684,114.00		\$19,570,000.00	\$4,665,000.00	\$672,828.00	\$8,776,286.00
0.8254243	Grand Guaranteed Maximum Price (GMP)	\$33,684,114.00	(Total of SFB Base Cost and District Cost)				

Offsite Adjacent Ways Scope of Work



Legend

- 7 - 4.7 - 31A Earthwork - 01 - 4" AC on 10" ABC on compacted subgrade - Q1 6,674 SY
- 9 - 1.2 - 3A.1 Offsite - 02 - 6" Vertical curb & Gutter per MAG STD. DTL. 220-1 type A - Q1 1,754 LF
- 10 - 1.2 - 3A.1 Offsite - 04 - Sidewalk per MAG STD. DTL. 230 - Q1 16,602 SF
- 11 - 4.7 - 31A Earthwork - 05 - 4" Decomposed Granite Pathway DSM PL4 - Q1 15,051 SF
- 12 - 4.7 - 31A Earthwork - 06 - Thickened Asphalt Edge per STD. DTL. 201 type A - Q1 1,820 LF
- 13 - 1.2 - 3A.1 Offsite - 07 - Sidewalk per MAG STD. DTL. 221 - Q1 599 SF
- 14 - 1.2 - 3A.1 Offsite - 08 - 4" roll curb and gutter per MAG STD. DTL. 220-1 Type C - Q1 47 LF
- 15 - 1.2 - 3A.1 Offsite - 09 - 5" Curb Transition per MAG STD. DTL. 221 - Q1 29 LF
- 16 - 4.7 - 31A Earthwork - 10 - Adjust manhole frame and cover MAG STD. DTL. 422 and 224 - Q1 15 EA
- 17 - 4.7 - 31A Earthwork - 11 - Sawcut and replace surface to existing asphalt pavement - Q1 1,723 LF
- 18 - 5.4 - 33A Site Utilities (Storm) - 12 - Install Catch Basin type E per MAG STD DTL 534-1 - Q1 11 EA
- 19 - 5.4 - 33A Site Utilities (Storm) - 13 - 12" RGRCP Pipe - Q1 112 LF
- 20 - 5.4 - 33A Site Utilities (Storm) - 14 - 18" RGRCP Pipe - Q1 897 LF
- 21 - 5.4 - 33A Site Utilities (Storm) - 15 - Headwall per MAG STD. DTL. 501-4 Type U - Q1 16 EA
- 22 - 4.7 - 31A Earthwork - 16 - Existing Utility Pole- PIP - Q1 21 EA
- 23 - 4.7 - 31A Earthwork - 17 - Existing Irrigation Canal - PIP - Q1 20 EA
- 24 - 4.7 - 31A Earthwork - 18 - Flush Basin - Q1 4 EA
- 25 - 4.7 - 31A Earthwork - 19 - Survey Marker per MAG STD. DTL 120-1 Type B - Q1 2 EA
- 26 - 4.7 - 31A Earthwork - 20 - Adjust valve boxes meter boxes, frames and coar per mag std. dtl. 270 - Q1 22 EA
- 27 - 4.7 - 31A Earthwork - 21 - 100yr, 2hr basin 4:1 - Q1 25,227 SF
- 28 - 1.2 - 3A.1 Offsite - 22 - 6" Wide Valley Gutter per MAG STD DTL 240 - Q1 1,766 SF
- 29 - 5.4 - 33A Site Utilities (Storm) - 23 - Storm Drain Manhole - Q1 2 EA
- 30 - 4.7 - 31A Earthwork - 24 - SWG Main - PIP - Q1 13 EA
- 31 - 4.7 - 31A Earthwork - 25 - Mill Existing Pavement 2" and replace with 2" asphalt - Q1 3,499 SY
- 49 - 4.7 - 31A Earthwork SWPPP - 03 - Straw Wattle per E3 on SWP-01.2 - Q1 3,839 LF
- 50 - 4.7 - 31A Earthwork SWPPP - 04 - Inlet Protection E3 on SWP-01.2 - Q1 214 LF
- 54 - 4.4 - 26A Electrical - 01 - Single Arm 12,000 Lumen LED Street Light 25' - Q1 6 EA
- 55 - 4.4 - 26A Electrical - 02 - Pull Box per ED3 Spec. 2.5" Conduit with (2) #12 THHN/THWN #12 - Q1 1,663 LF
- 66 - 5.4 - 33A Site Water Utilities - 01 - Pothole and Verify - Q1 1 EA
- 67 - 5.4 - 33A Site Water Utilities - 02 - Remove existing polug and extend waterline - Q1 1 EA
- 68 - 5.4 - 33A Site Water Utilities - 03 - 16" Polywrapped DIP Waterline - Q1 7,948 LF
- 69 - 5.4 - 33A Site Water Utilities - 04 - Fire Hydrant - Q1 5 EA
- 70 - 5.4 - 33A Site Water Utilities - 05 - 16" gate valve with v&c - Q1 11 EA
- 71 - 5.4 - 33A Site Water Utilities - 06 - Tee Bend per MAG STD. DTL 303-1 and 303-2 - Q1 5 EA
- 72 - 5.4 - 33A Site Water Utilities - 07 - Vertical Re-alignment - Q1 4 EA
- 73 - 5.4 - 33A Site Water Utilities - 08 - 2" Air Release Valve per GWR STD DTL 338-1 - Q1 3 EA
- 74 - 5.4 - 33A Site Water Utilities - 09 - Install Cross per MAG STD DTL 303-1 - Q1 2 EA
- 75 - 5.4 - 33A Site Water Utilities - 10 - Install Plug Blocking and Mark per MAG STD DTL 390-B - Q1 3 EA
- 76 - 5.4 - 33A Site Water Utilities - 11 - Caution - existing utilities - Q1 8 EA
- 77 - 5.4 - 33A Site Water Utilities - 12 - Install Tap Sleeve and Water Meter Per DTL 310-3 - Q1 3 EA
- 78 - 5.4 - 33A Site Water Utilities - 13 - Install 2" double check backflow per STD DTL 350-1 - Q1 2 EA
- 79 - 5.4 - 33A Site Reclaimed Water Utilities - 01 - Pothole - Q1 1 EA
- 80 - 5.4 - 33A Site Reclaimed Water Utilities - 02 - Plug Reclaimed waterline - Q1 1 EA
- 81 - 5.4 - 33A Site Reclaimed Water Utilities - 03 - 16" PVC C900 Reclaimed Line - Q1 5,562 LF
- 82 - 5.4 - 33A Site Reclaimed Water Utilities - 04 - 16" Gate Valve w/ V&C - Q1 5 EA
- 83 - 5.4 - 33A Site Reclaimed Water Utilities - 05 - Vertical Re-Alignment - Q1 3 EA
- 84 - 5.4 - 33A Site Reclaimed Water Utilities - 06 - Polywrapped DIP Waterline - Q1 3 EA
- 85 - 5.4 - 33A Site Reclaimed Water Utilities - 07 - 2" Air Release Valve per DTL388-1 - Q1 1 EA
- 87 - 5.4 - 33A Site Reclaimed Water Utilities - 09 - Tap Sleeve and Water Meter per DTL 310-3 - Q1 6 EA
- 89 - 5.0 - 32B Landscaping - 00 - Landscape Buffer - Q1 523 SY
- 90 - 5.4 - 33A Site Utilities (Storm) - Grouted Rip-Rap - Q1 5,847 SF
- 93 - 4.7 - 31A Earthwork - 03 - 6" single curb per MAG STD DTL. 222 type A - Q1 15 LF
- 95 - 4.4 - 26A Electrical - 03 - Offsite Primary / Communications - Q1 1,866 LF
- 99 - 5.4 - 33A Site Water Utilities - MSIDD Utility Crossings - Q1 6 EA

No.	Description	Date


MARICOPA HIGH
SCHOOL

ON &
OFFSITE

PROJECT NUMBER	
DATE	
DRAWN BY	
CHECKED BY	
	C0.0
SCALE	



On-Site Adjacent Ways Scope of Work

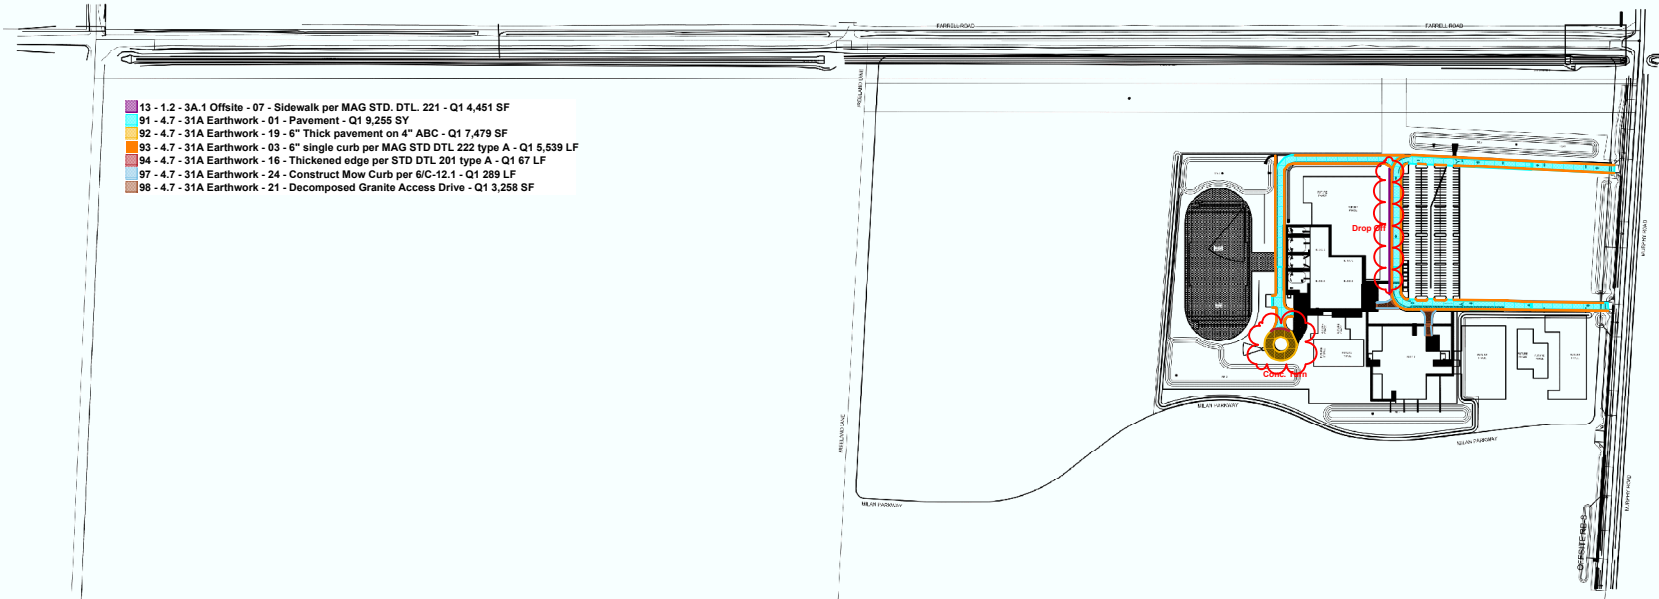

No.	Description	Date

MARICOPA HIGH
SCHOOL

ON &
OFFSITE

PROJECT NUMBER	
DATE	
DRAWN BY	
CHECKED BY	
	C0.0
SCALE	