


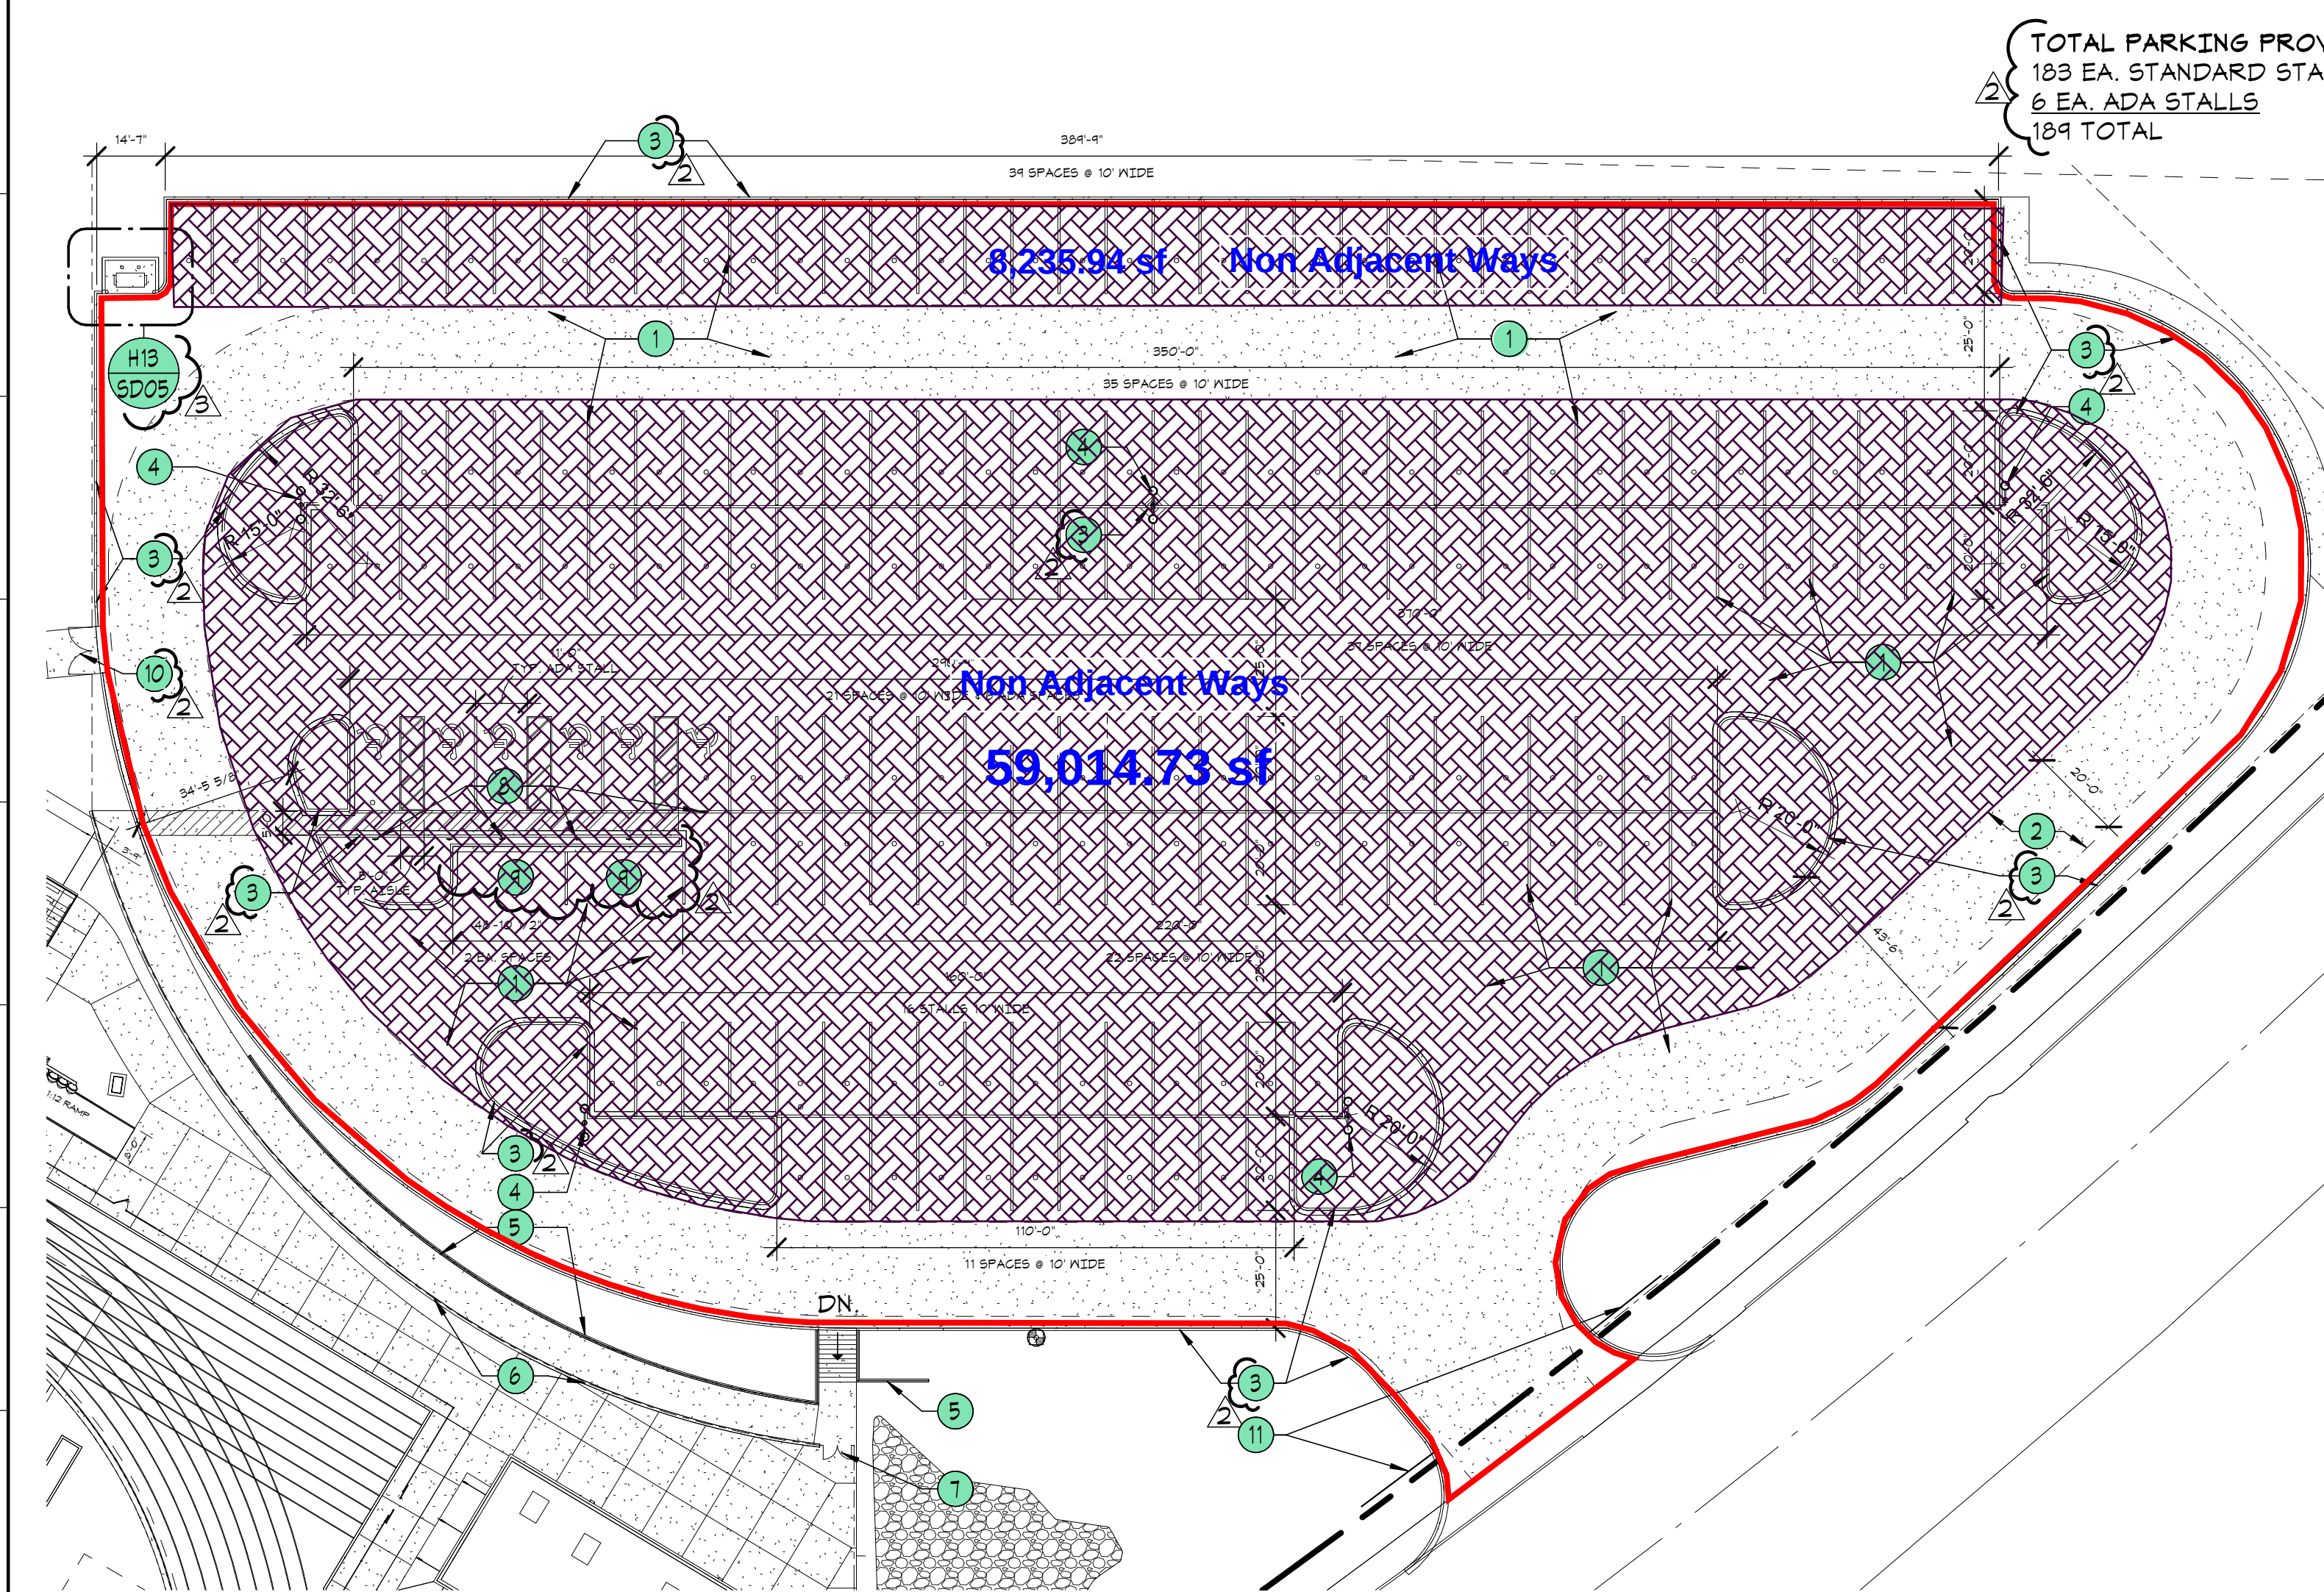
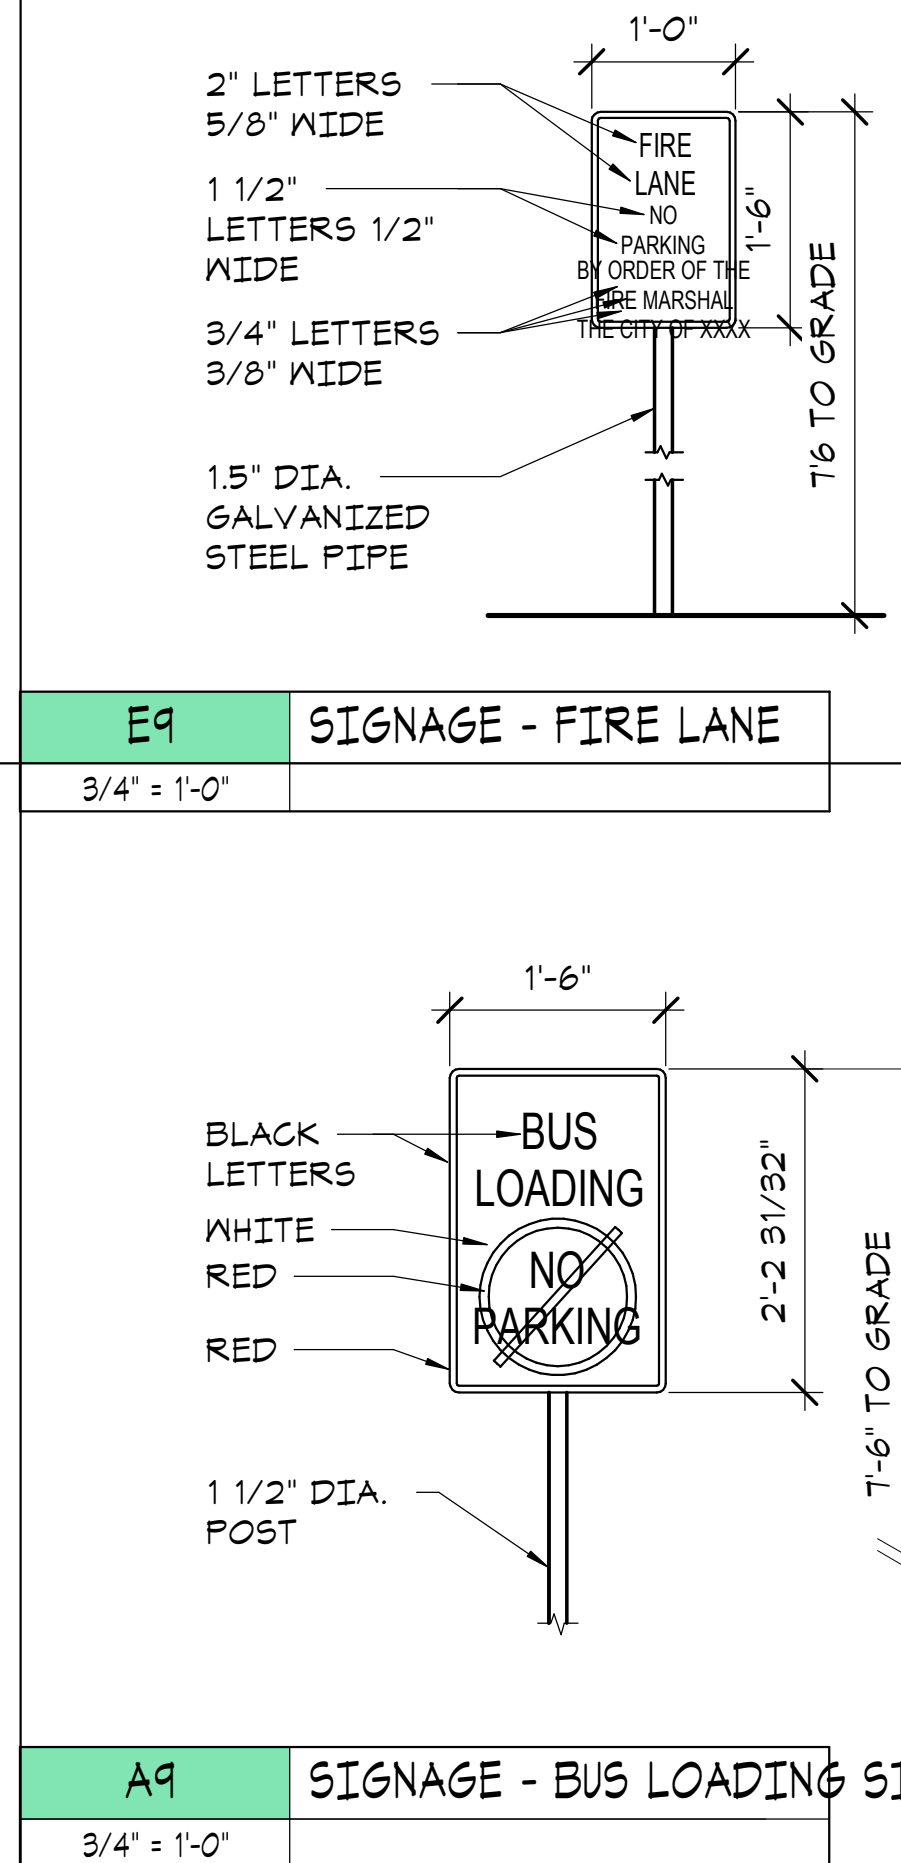
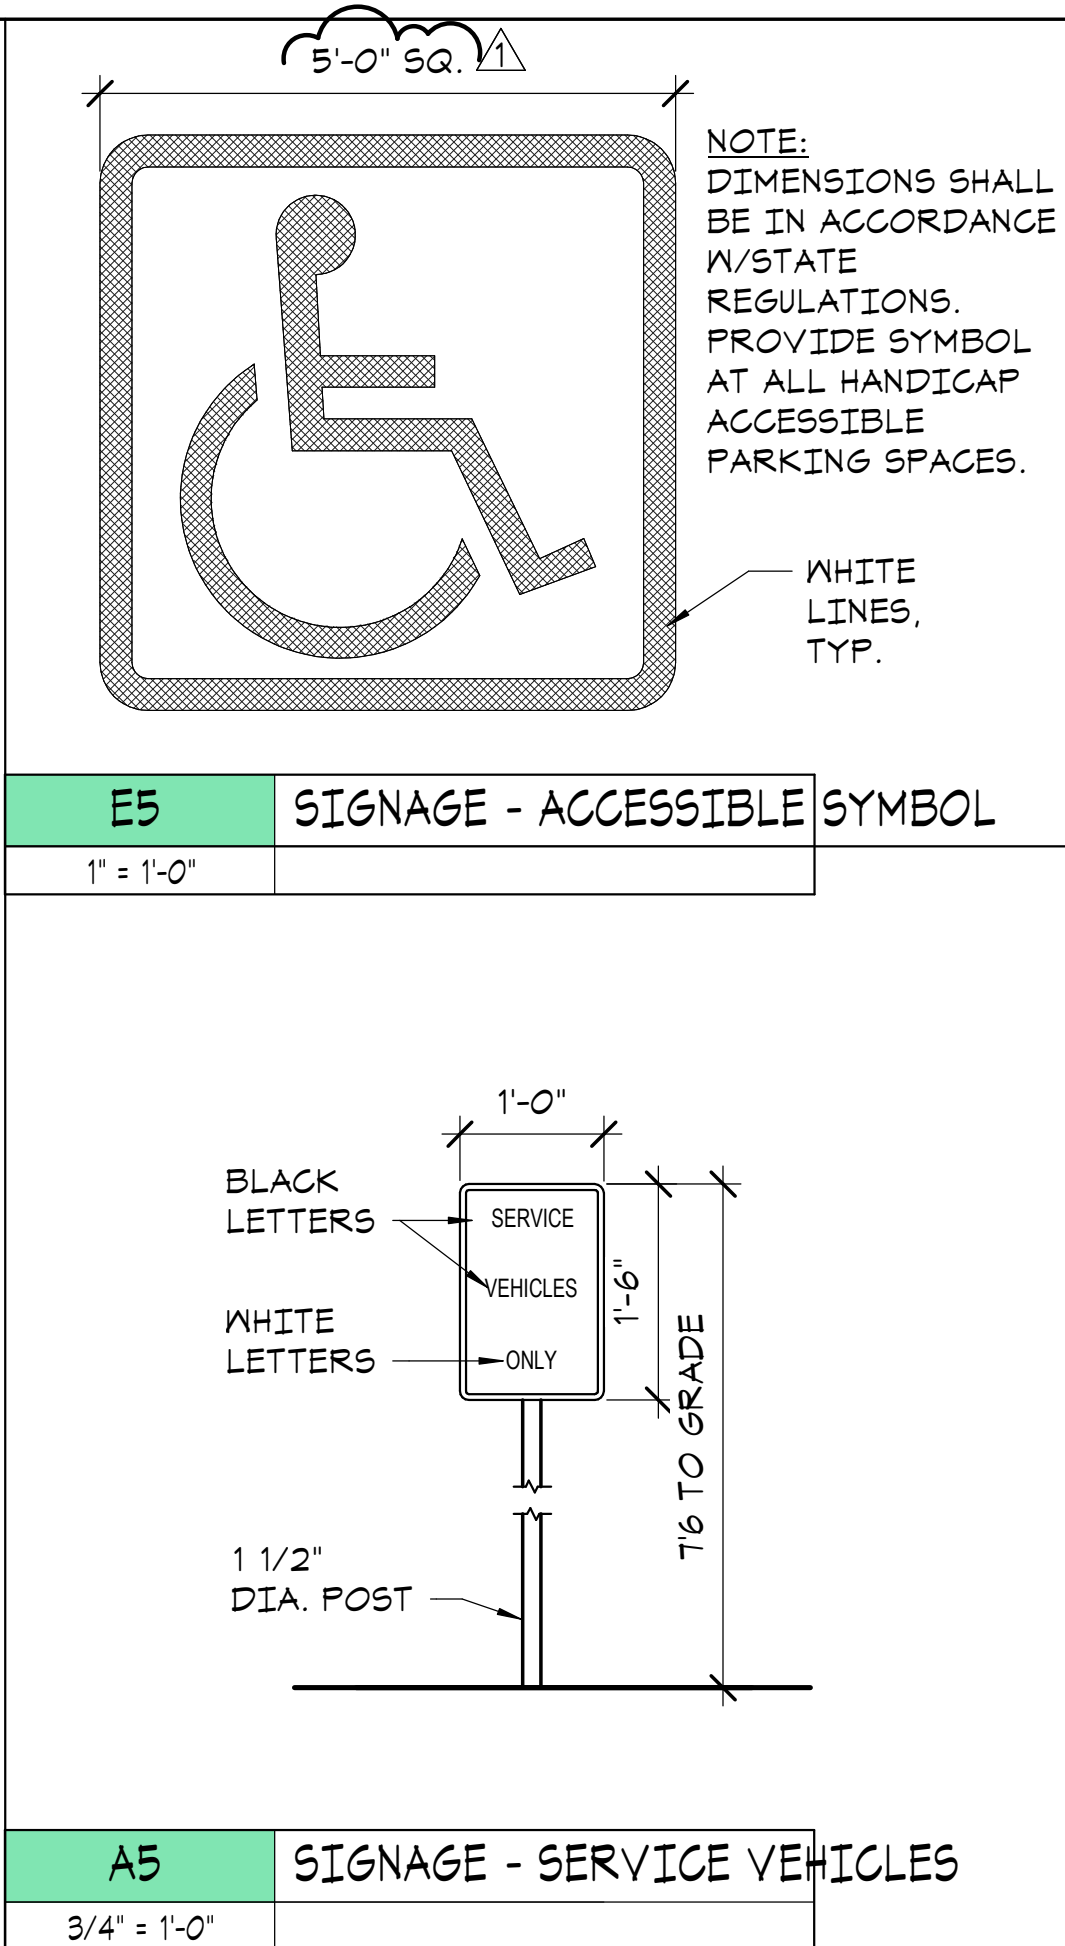
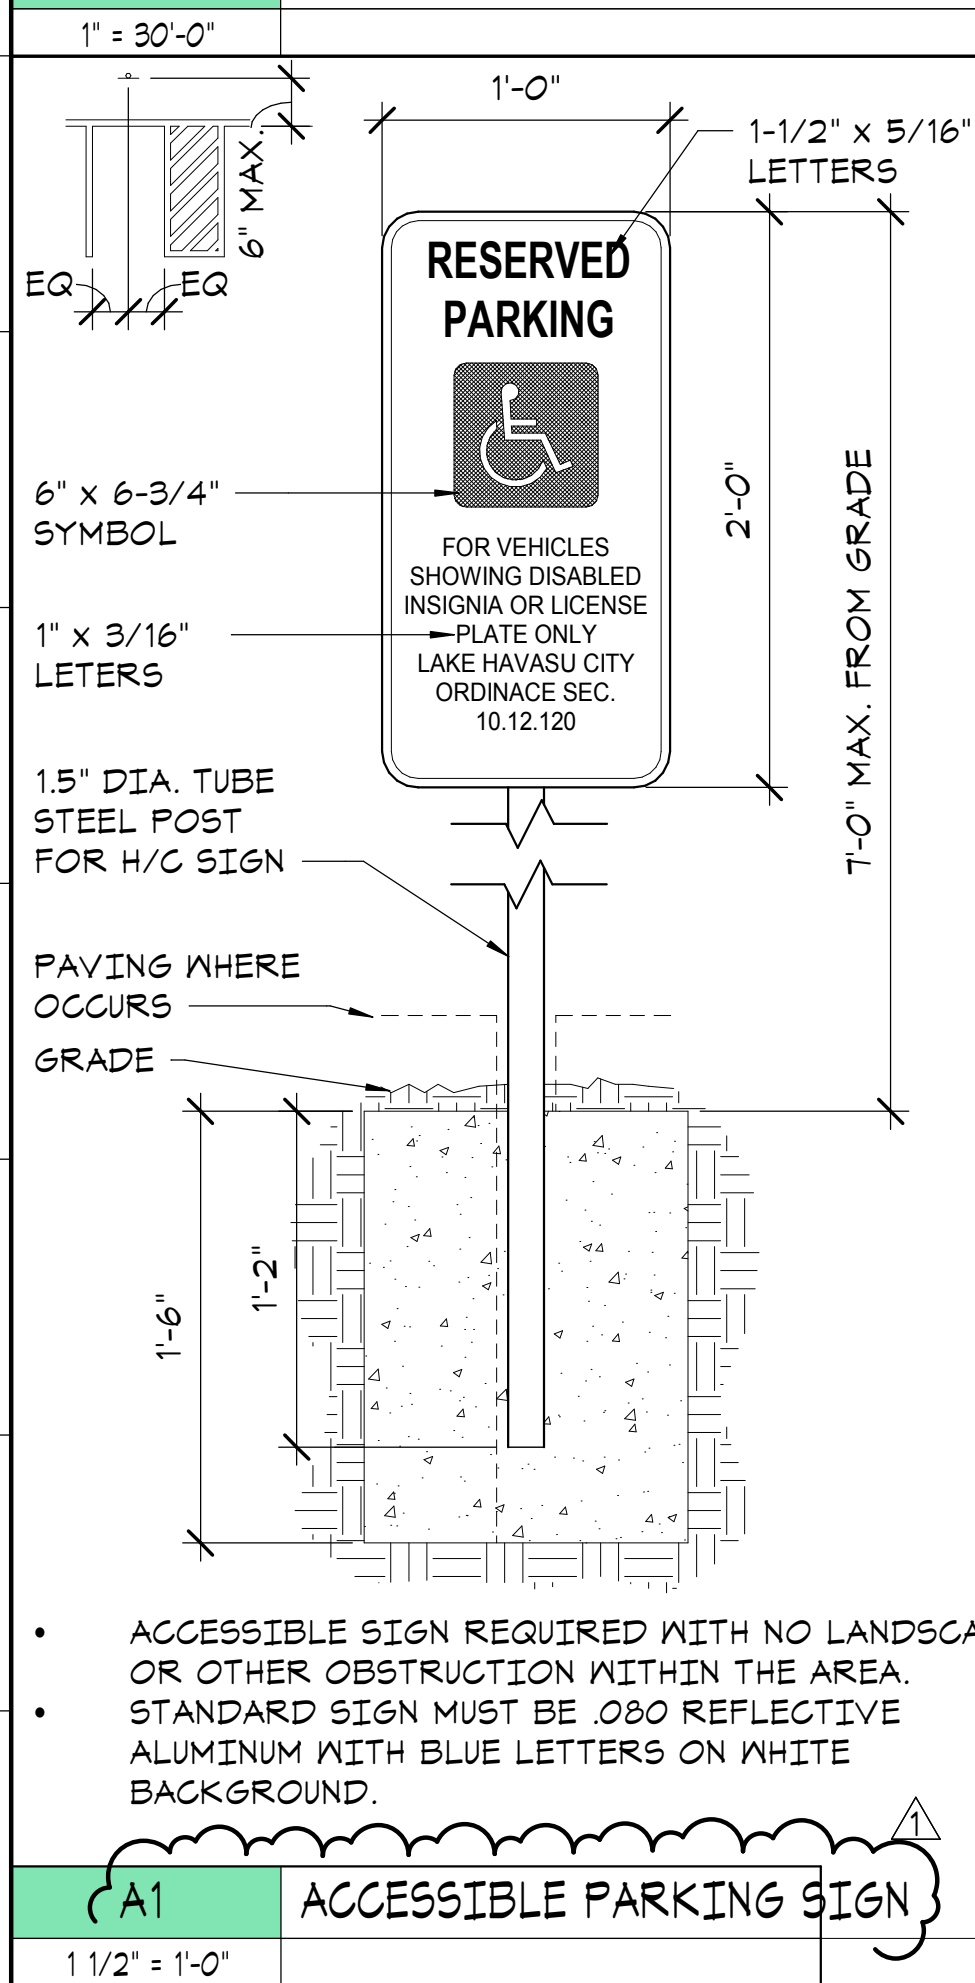
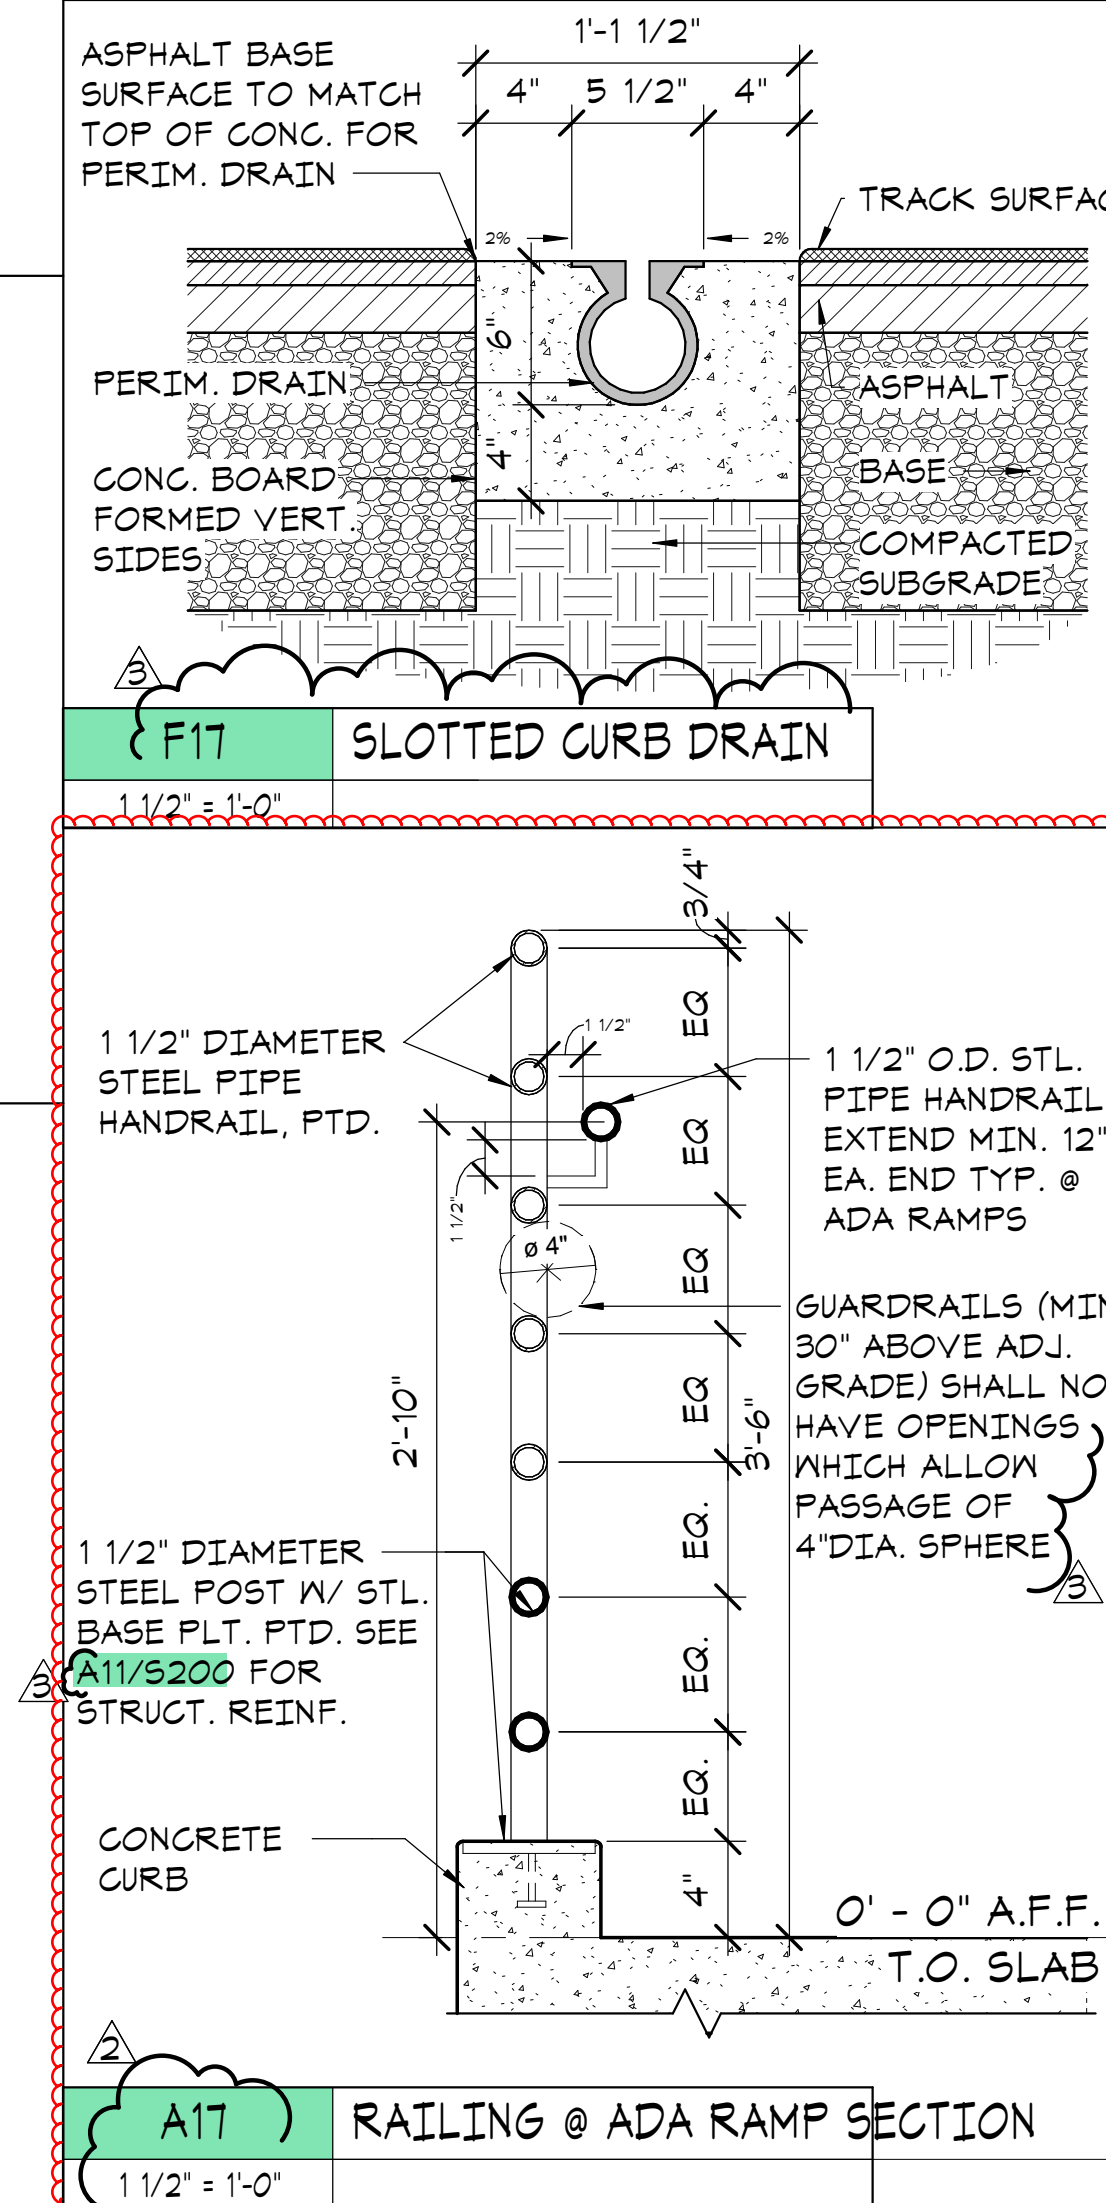


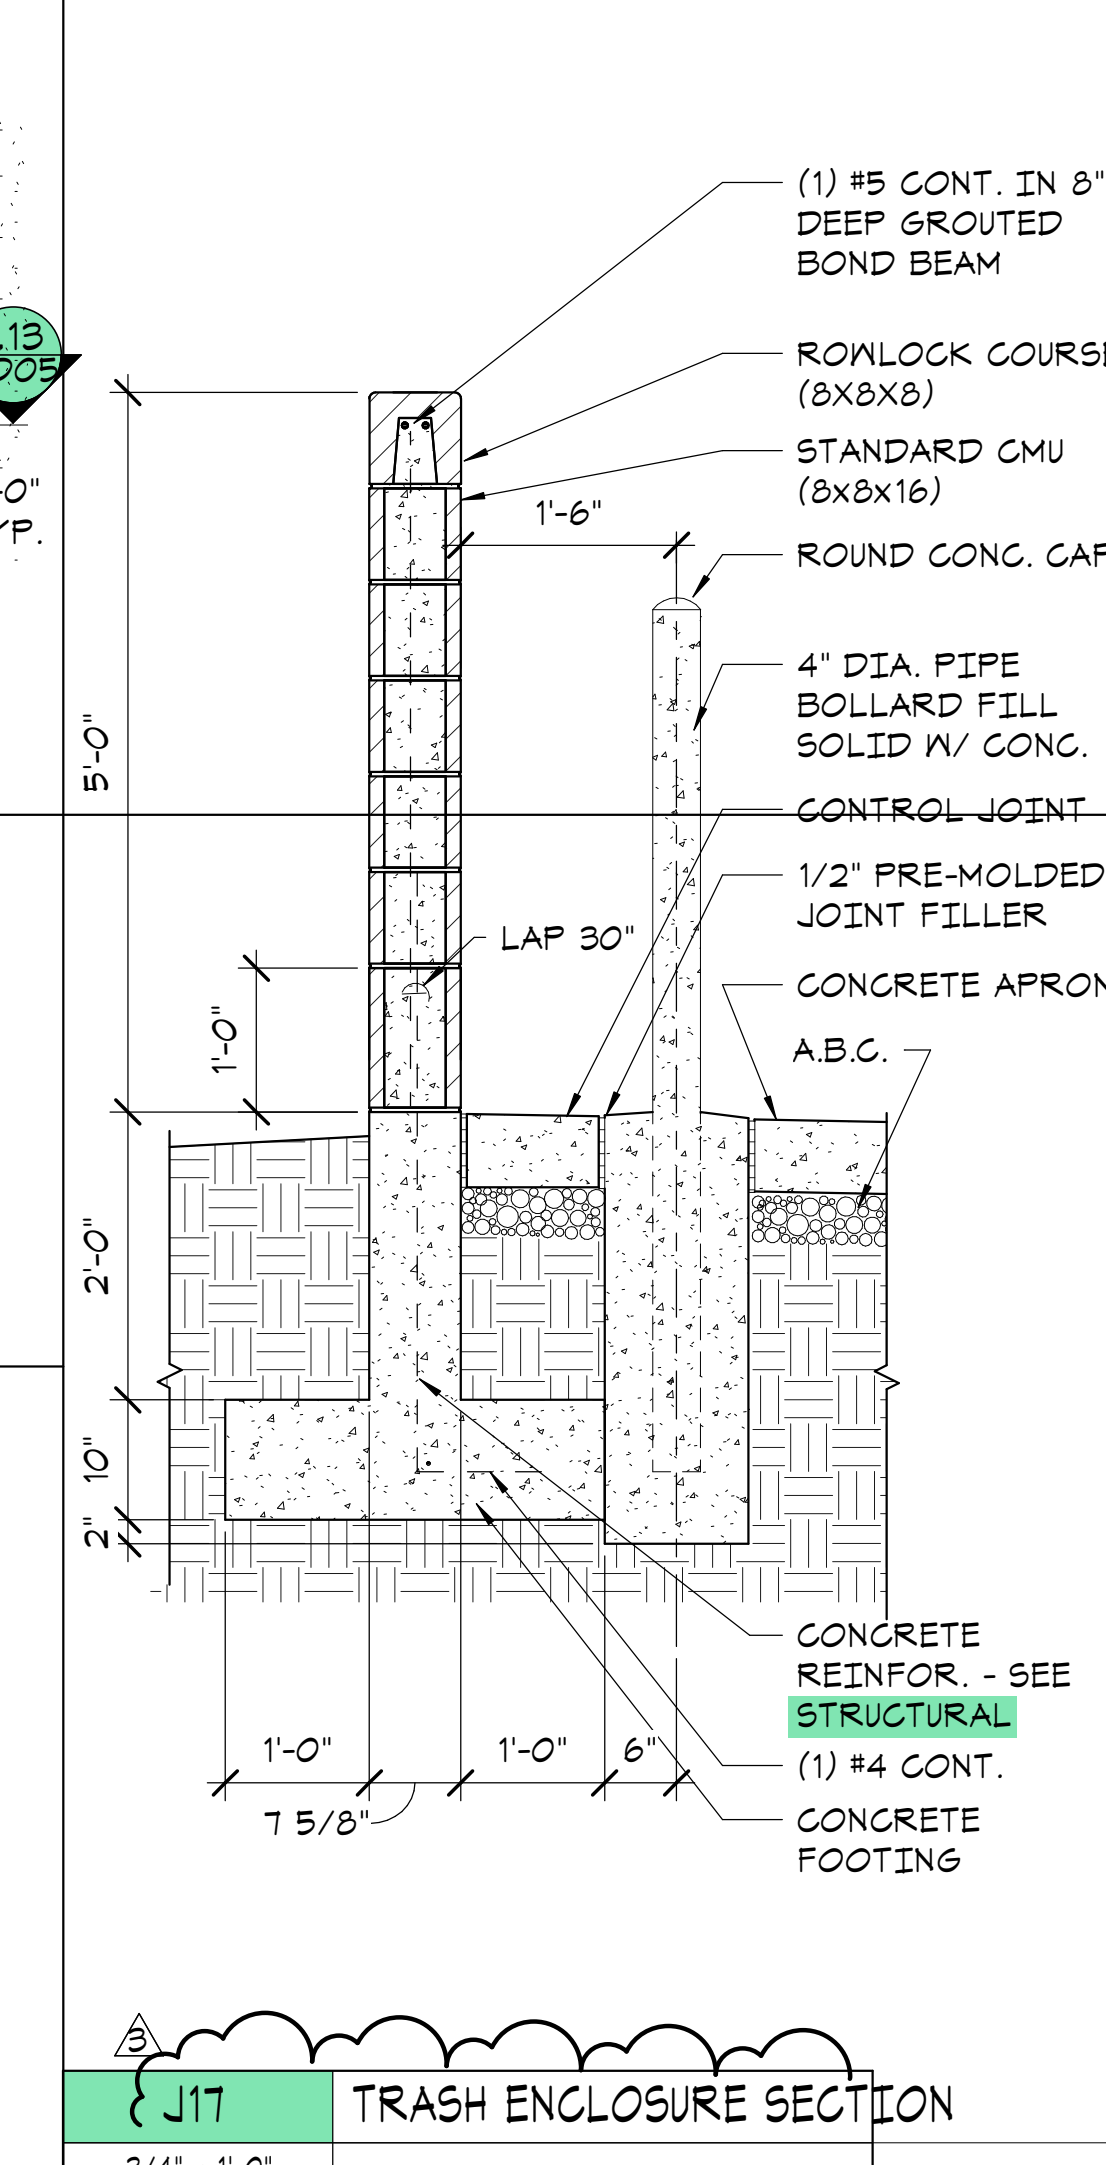

J1 ENLARGED PARKING PLAN

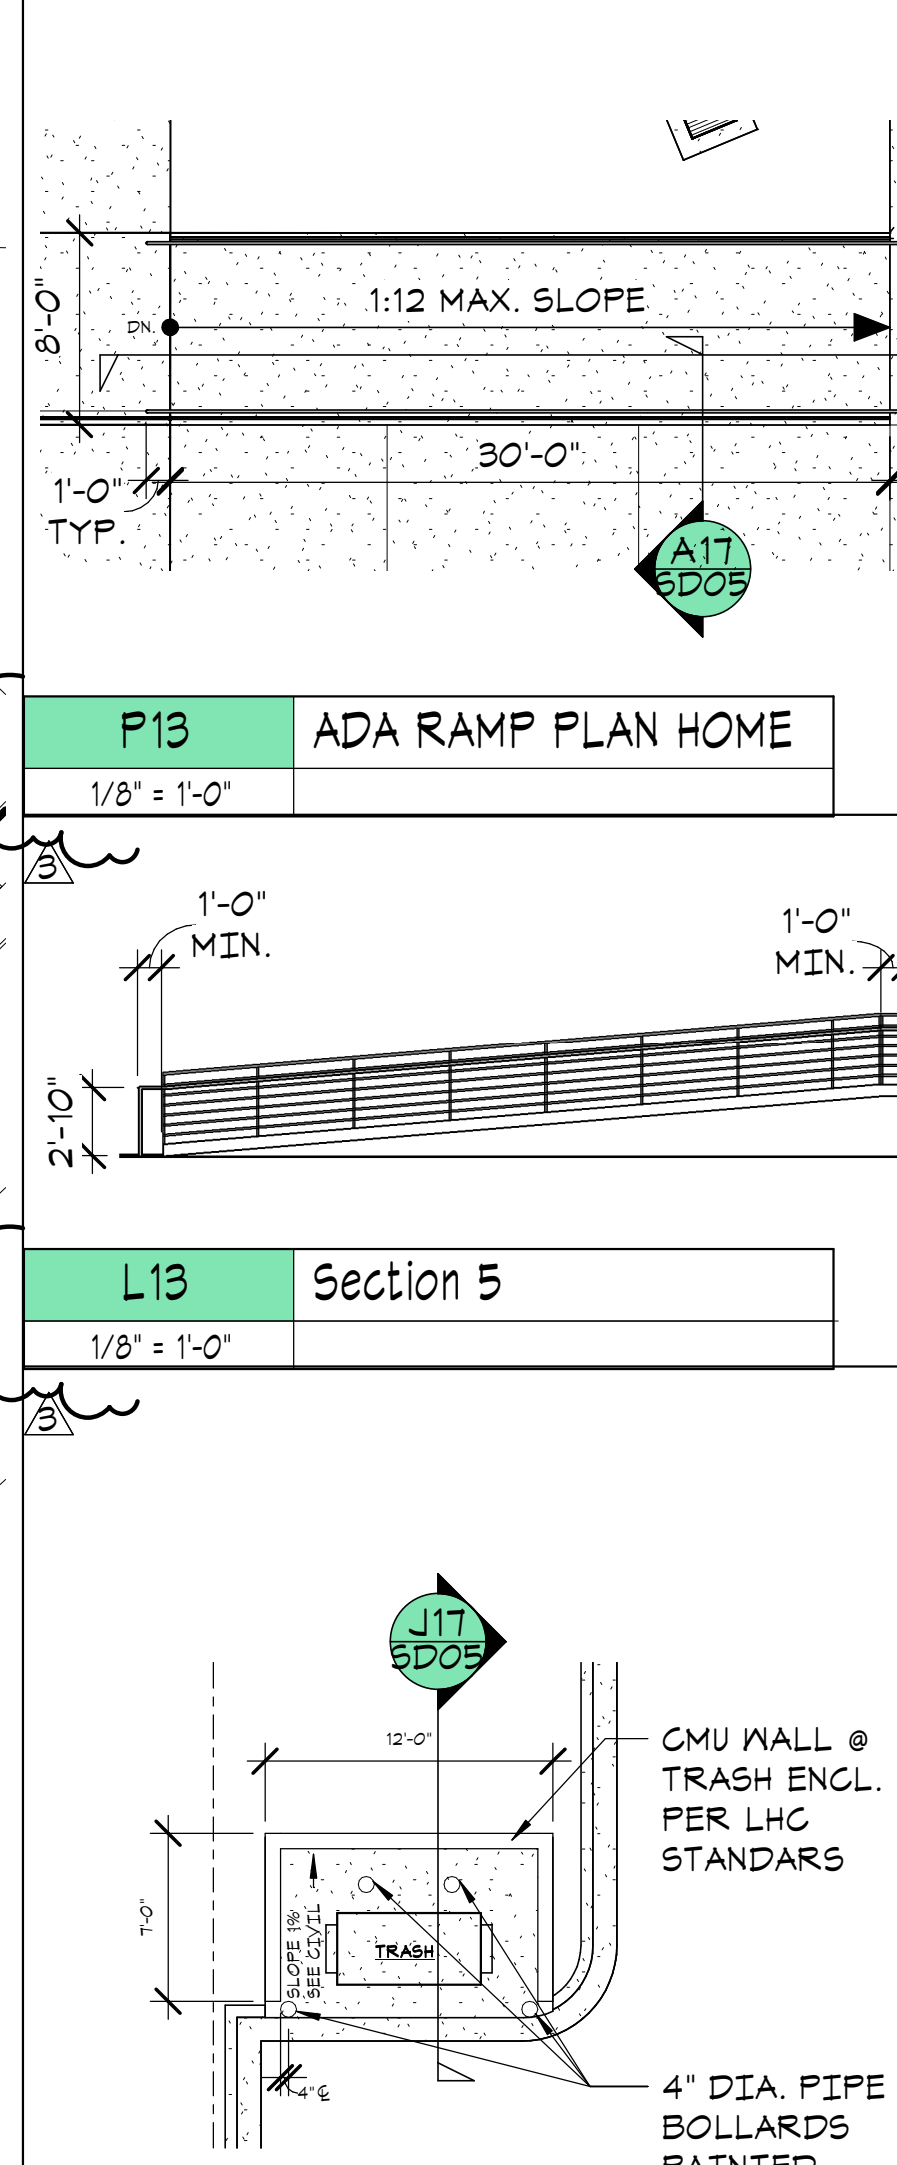

H13 ENLARGED DUMPSTER PLAN

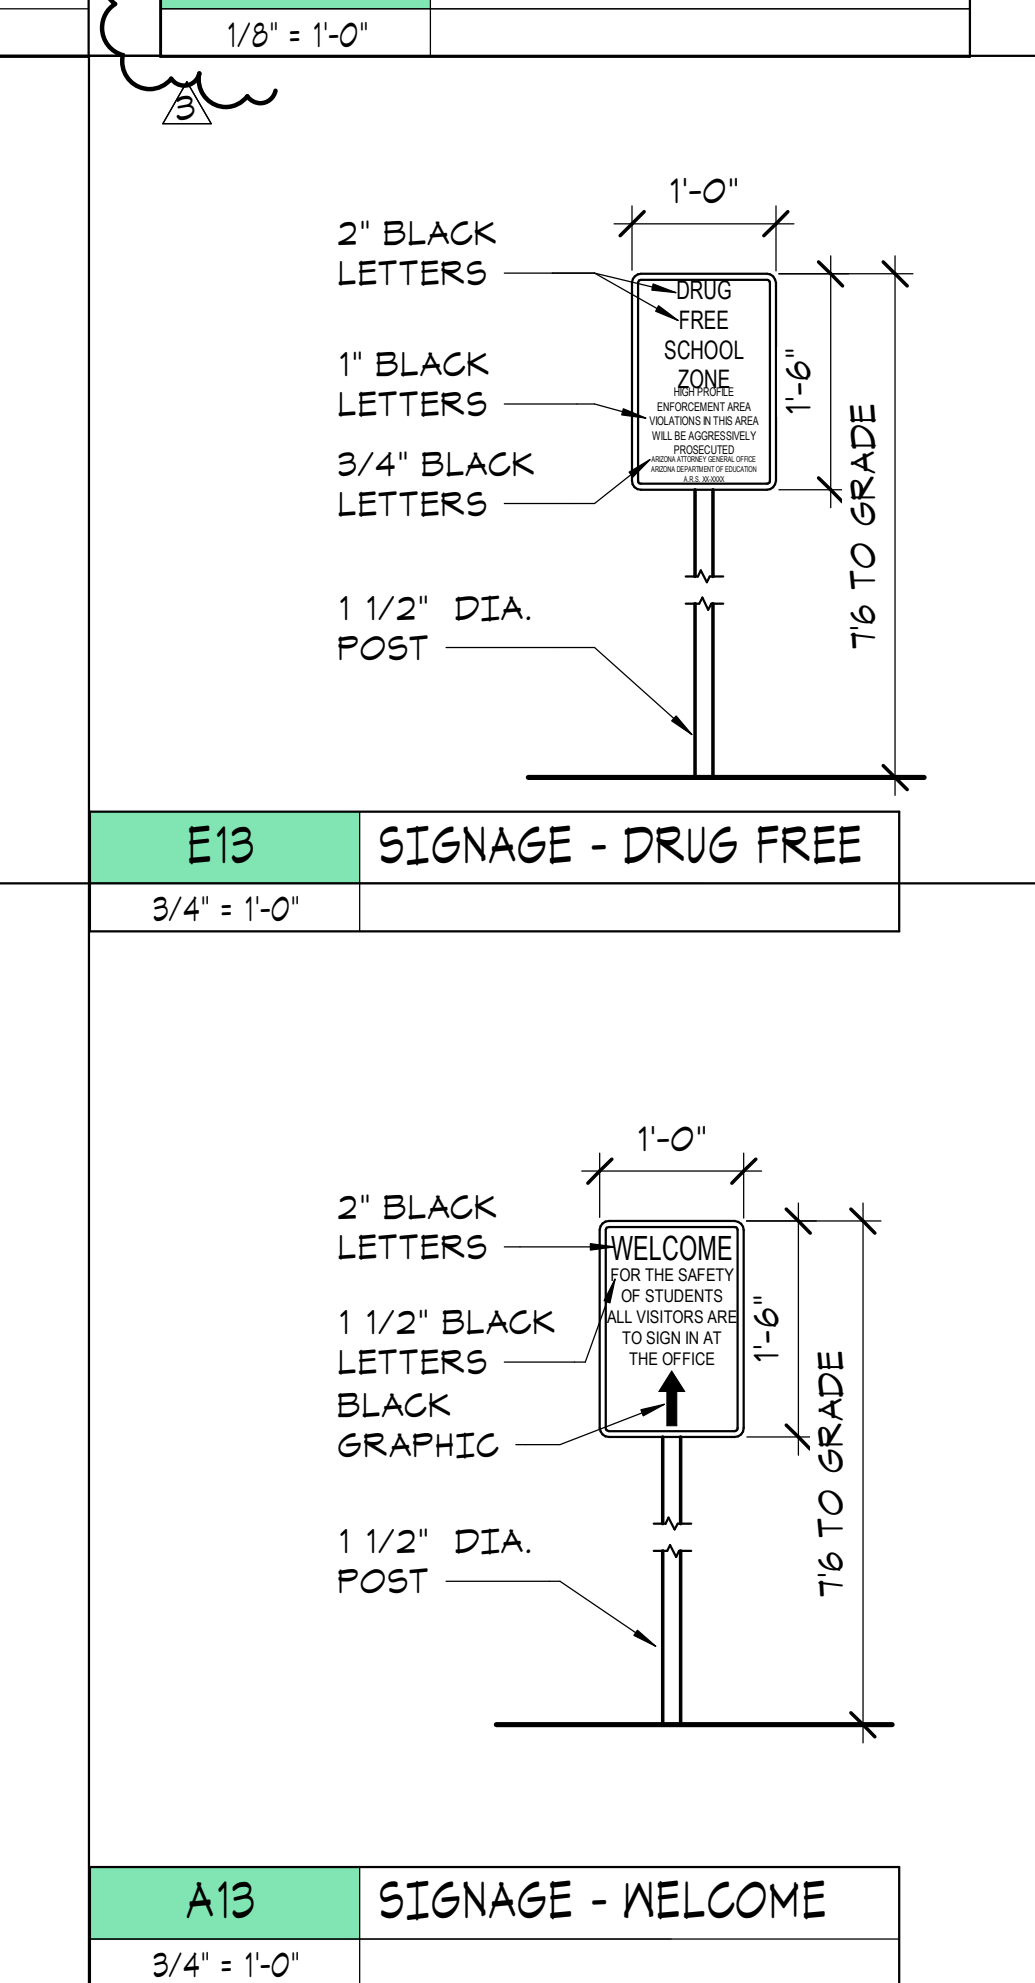

- KEYNOTES**
1. ASPHALT PAVING W/ 2" PARKING LANE STRIPING.
 2. DENOTES FIRE TRUCK ACCESS.
 3. 6" CONC. CURB AND GUTTER SEE CIVIL.
 4. PARKING LOT LIGHTING SEE ELEC.
 5. SITE RETAINING WALL W/ 42" GUARDRAIL.
 6. SITE RETAINING WALL W/ 6" DECO. STL. FENCE.
 7. PAIR 4"W X 6"H DECO. STL. LOCKABLE ACCESS GATE W/ HOLD OPEN.
 8. ACCESSIBLE PARKING SIGN TYP. AT ADA PARKING STALL SEE A1/SD05.
 9. PARALLEL PARKING STALL.
 10. PAIR 5"W X 6"H DECO. STL. LOCKABLE ACCESS GATES W/ HOLD OPEN.
 11. PAIR 20"W X 6"H DECO. STL. ROLLING LOCKABLE ACCESS GATE SEE 8/SD08.
 12. 3"W X 6"H LOCKABLE DECO. STL. ACCESS GATE.

LHHS Football Field Parking Lot

SCOPE See detail J1

Crack Sean and Seal-coat approximately 93,561 sf

Adjacent Ways:
On KEYNOTE #2 above denotes fire truck lane. This section sf cost needs to be broken out as adjacent ways.

Approximately 26,310 sf.

All denoted fire lane curbs will require paint. and must state on curb "FIRE LANE NO PARKING".

Non Adjacent Ways:
Approximately 67251 sf

181 parking spots
6 ADA parking spots
179 parking spots require 12" numbering

Revised 4/25/2023

AS BUILTS

RFI 033

#	REVISIONS / SUBMISSIONS	DATE
3	City Review Comments	3/8/18
2	Client Coordination	1/26/18
1	City Revisions 1	1/22/18

LAKE HAVASU UNIFIED SCHOOL DISTRICT #1

LAKE HAVASU HIGH SCHOOL FIELD RENOVATIONS

2675 Palo Verde Boulevard South, Lake Havasu, AZ 86403

Emc2 Architects ■ Planners, PC

Emc2 GROUP ARCHITECTS/PLANNERS, PC
1635 N. Greenfield Road, Suite 144
Mesa, Arizona 85205
P 480 830 3838
F 480 830 3860
www.emc2architects.com

DRAWING TITLE: **ENLARGED PLANS CONT.**

DESIGNED BY:	PROJECT NO.
Emc2	9216451

DRAWN BY:	SCALE:
Emc2	As indicated

CHECKED BY:	DRAWING NO.
Emc2	SD05

CORE CONSTRUCTION
3036 E. Greenway Road, Phoenix, AZ 85032-4414
RECORD DRAWINGS

DATE: 12/22/17
DATA FILE: 488.01_HS Field.rvt