



**GILLELAND
BRUBAKER
ARCHITECTS**
9017 NORTH 57th DRIVE
GLENDALE, ARIZONA 85302
PHONE: (602) 937-5777 FAX: (602) 937-5778

As-Built


OVERALL SITE PLAN

Maricopa District Offices
14150 W. Maricopa-Casa Grande Hwy.
Maricopa, Arizona 85239

Maricopa Unified School District 20
Maricopa, Arizona

AO.1

07-34

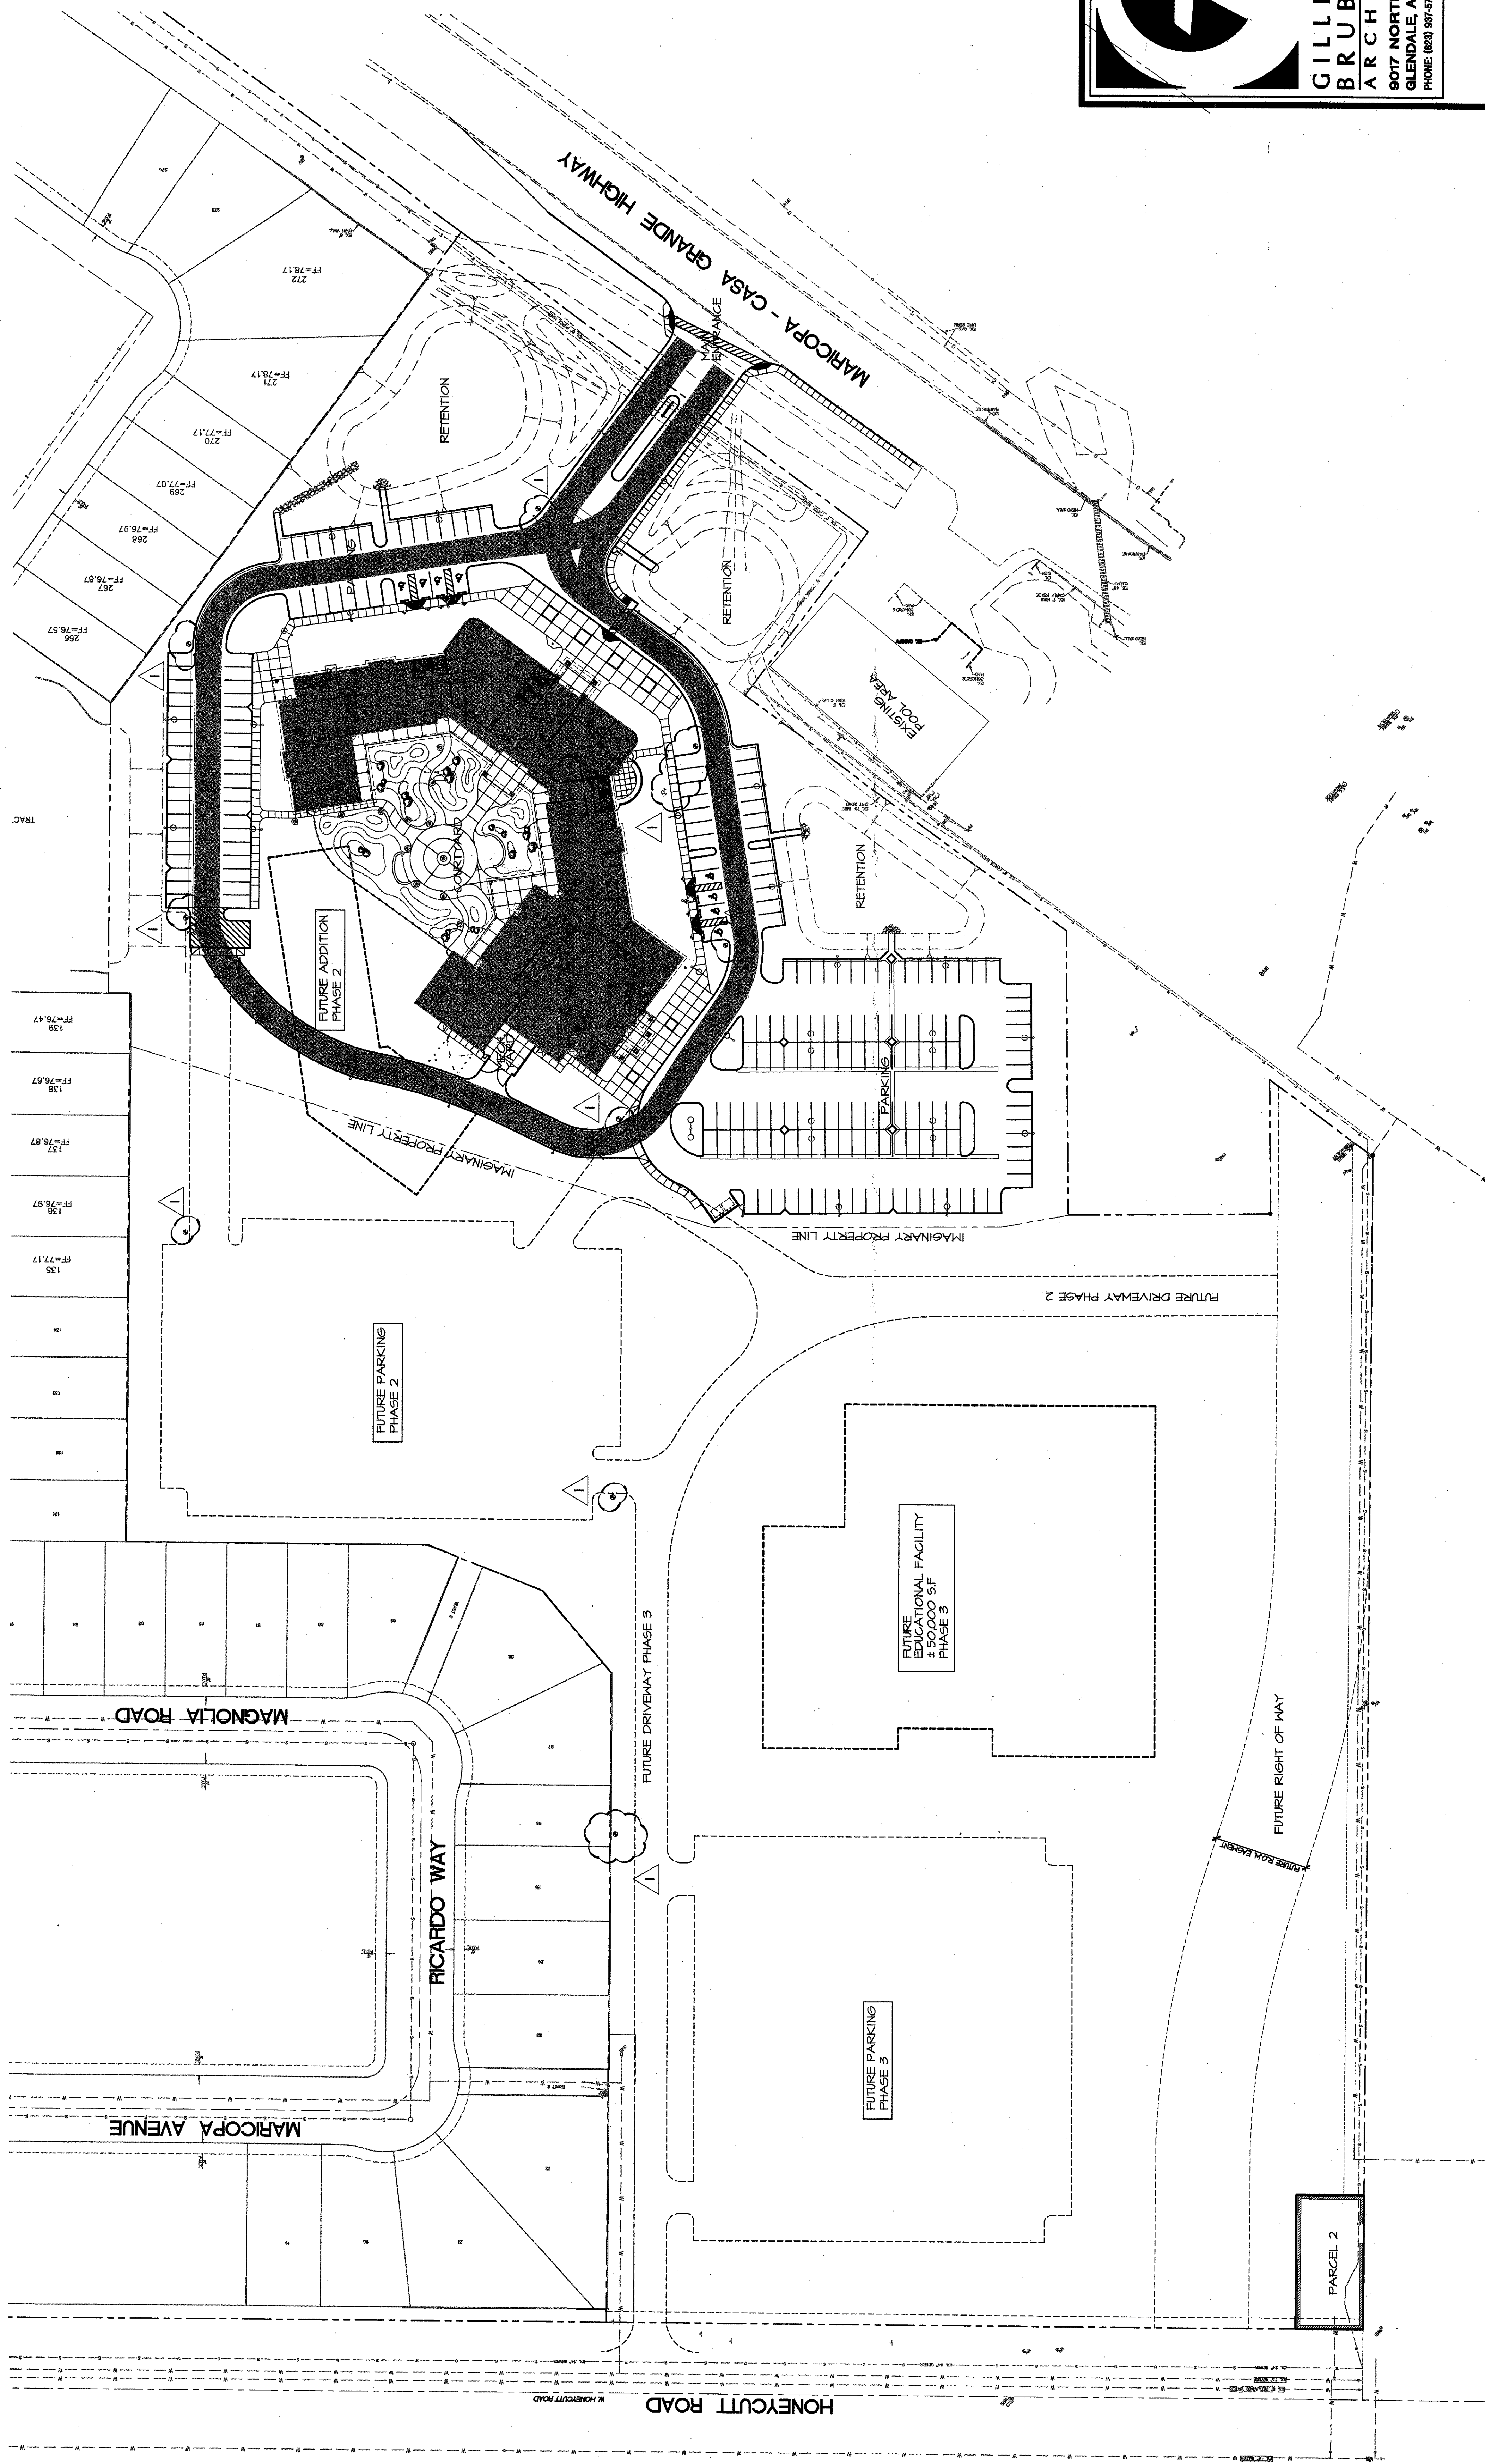

OVERALL SITE PLAN

SCALE: 1" = 50'-0"

