


KEYNOTES

APPLY TO THIS SHEET ONLY

1. SERVICE GATE PER DETAIL 19 / A02.
2. 14" DOORS PER DETAIL 14 / A02 & DOOR SCHEDULE DETAILS 4 / A02.
3. 8'-0" HIGH 8" WIDE MASONRY SERVICE YARD WALL.
4. TUBE STEEL DOUBLE LEAF GATE PER DETAIL 11B / A02.
5. TRASH ENCLOSURE - SEE DETAIL 9 / A02 & CIVIL DWGS.
6. TUBE STEEL FENCE PER DETAIL 12 / A02.
7. TUBE STEEL SINGLE LEAF GATE PER DETAIL 5 / A02 SH. SEE DETAIL 12 / A02 SH.
8. TUBE STEEL FENCE FOR ENCLOSED BIKE RACK AREA - SEE DETAIL 12 / A02 SH.
9. PARENT DROP OFF LANE PER CIVIL DRAWINGS.
10. 20'-0" WIDE FIRE LANE PER FIRE MARSHAL - SEE CIVIL DRAWINGS.
11. BASKETBALL COURT PER CIVIL DRAWINGS.
12. NEW SITE WALL SHALL MATCH EXISTING HEIGHT.
13. BUS LOADING LANE PER CIVIL DRAWINGS.
14. PLAY FIELDS - SEE CIVIL DRAWINGS AND LANDSCAPE.
15. FLAG POLE PER DETAIL 2 / A02.
16. SOFTBALL AREA - DEPRESS 12" TO RECEIVE PLAY SAND PROVIDED BY LANDSCAPE CONTRACTOR PER CIVIL DRAWINGS.
17. TURF AREA - SEE LANDSCAPE DWGS AND CIVIL.
18. BACK STOP PER CIVIL DRAWINGS.
19. PIPE BOLLARD PER DETAIL 1 / A02.
20. CAN WASH PER DETAIL 2 / A01.
21. EXISTING CULVERT.
22. EXISTING MASONRY SITE WALL.
23. CURB PER CIVIL DRAWINGS.
24. MASONRY COLUMNS SEE FLOOR PLANS AND STRUCT.
25. EXISTING TRANSFORMERS.
26. ASPHALTIC CONCRETE PAVEMENT PER CIVIL DWGS.
27. CURB BORDER PER LANDSCAPE DRAWINGS.
28. CONCRETE WALK PER CIVIL DWGS.
29. D.S. AREA PER LANDSCAPE DWGS.
30. SINGLE LEAF GATE PER DETAIL 11A / A02.
31. DOUBLE LEAF GATE PER DETAIL 11A / A02.
32. CONCRETE RAMP PER CIVIL DWGS.

GENERAL NOTE:
LOCK BOX (KNOX BOX) SHALL BE PROVIDED AT ALL EXTERIOR GATES THAT ARE LOCKED. LANDSCAPE CONTRACTOR SHALL PROVIDE LOCK BOXES PRIOR TO FINAL CITY INSPECTION.

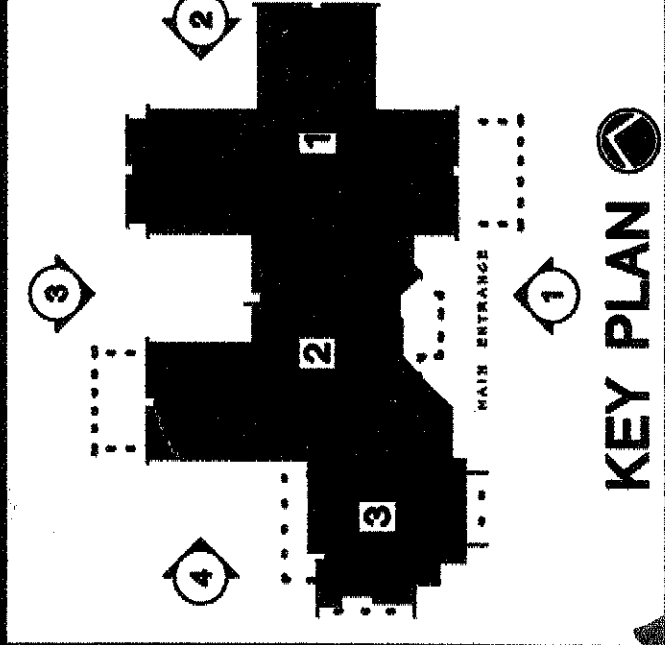

GILLES AND BRUBAKER ARCHITECTS
9017 NORTH 57TH DRIVE
GLENDALE, ARIZONA 85302
PHONE (602) 937-5771 FAX (602) 937-5778

SITE PLAN

NEW MARICOPA
ELEMENTARY SITE 11-22
RANCHO EL DORADO
MARICOPA UNIFIED SCHOOL DISTRICT #20
4012 W. HANCOCK AVENUE
MARICOPA, ARIZONA 85229

A0.1
0103

*Take all sheets
from this sheet*

*Label all sheets
As-Built*



RANCHO EL DORADO PARKWAY

SITE PLAN



SCALE: 1" = 30'-0"