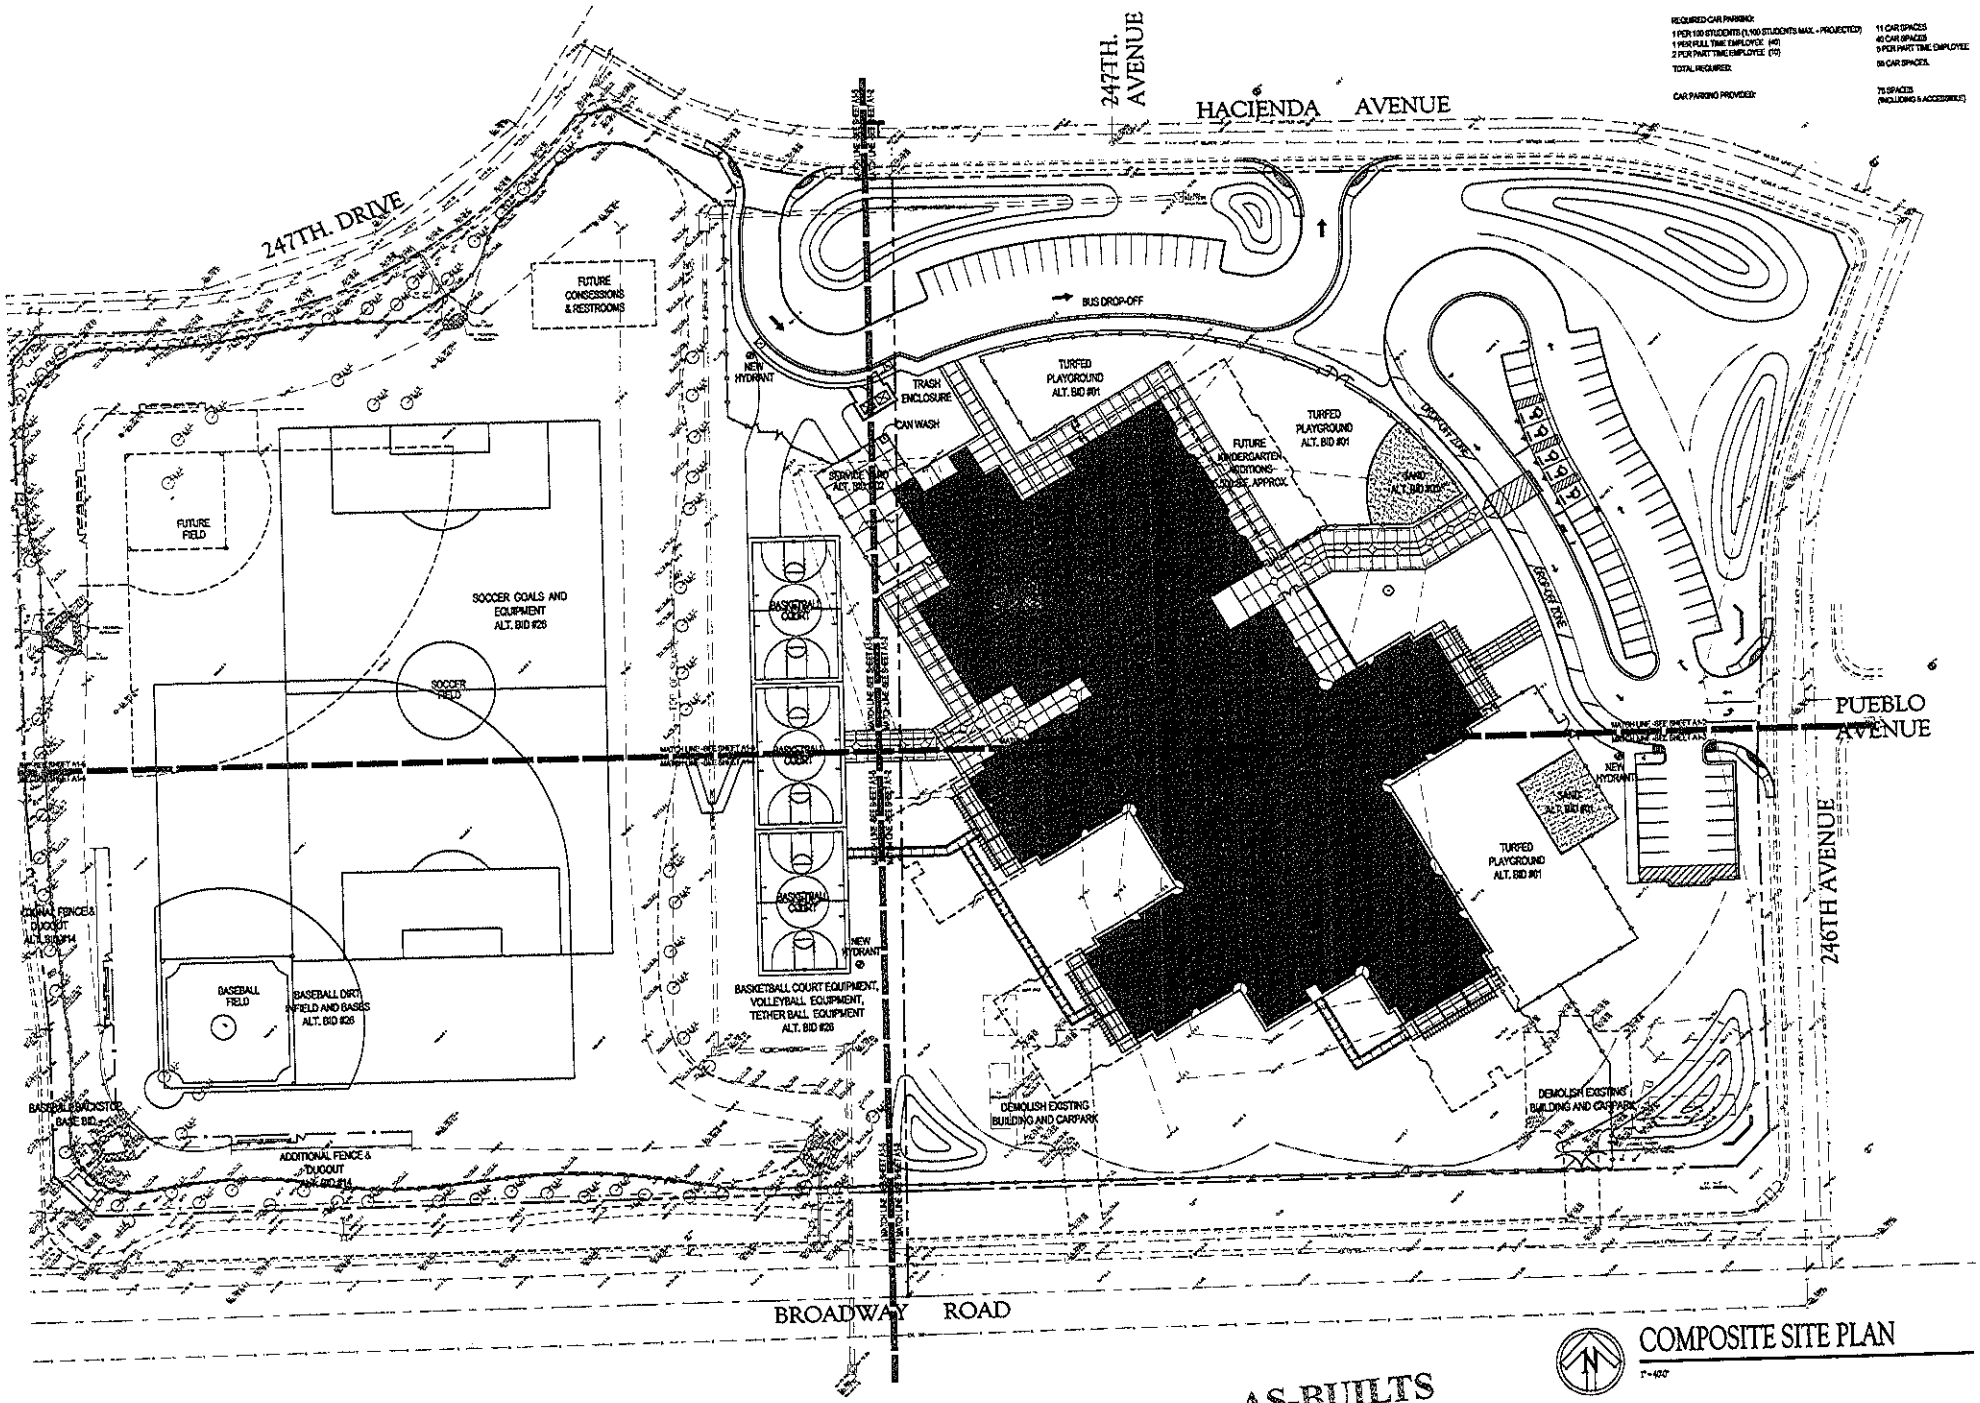


COMPOSITE SITE PLAN

AS-BUILTS

HUNT
Arc
714
Glendale,
Voice (623)

ASFB Project # 07043300099900 8N

STEVEN R. IASINSKI