

Campo Bello Elementary Replacement School

PARADISE VALLEY SCHOOLS
 2650 E. Conley Ave., Phoenix, AZ 85032


CLIENT CONTACT: [Name]
 PROJECT NO.: 18-113
 DATE: 11/28/2018
 DRAWN BY: [Signature]
 CHECKED BY: [Signature]

PROJECT NO.: 18-113
 DATE: 11/28/2018
 DRAWN BY: [Signature]
 CHECKED BY: [Signature]

AS102



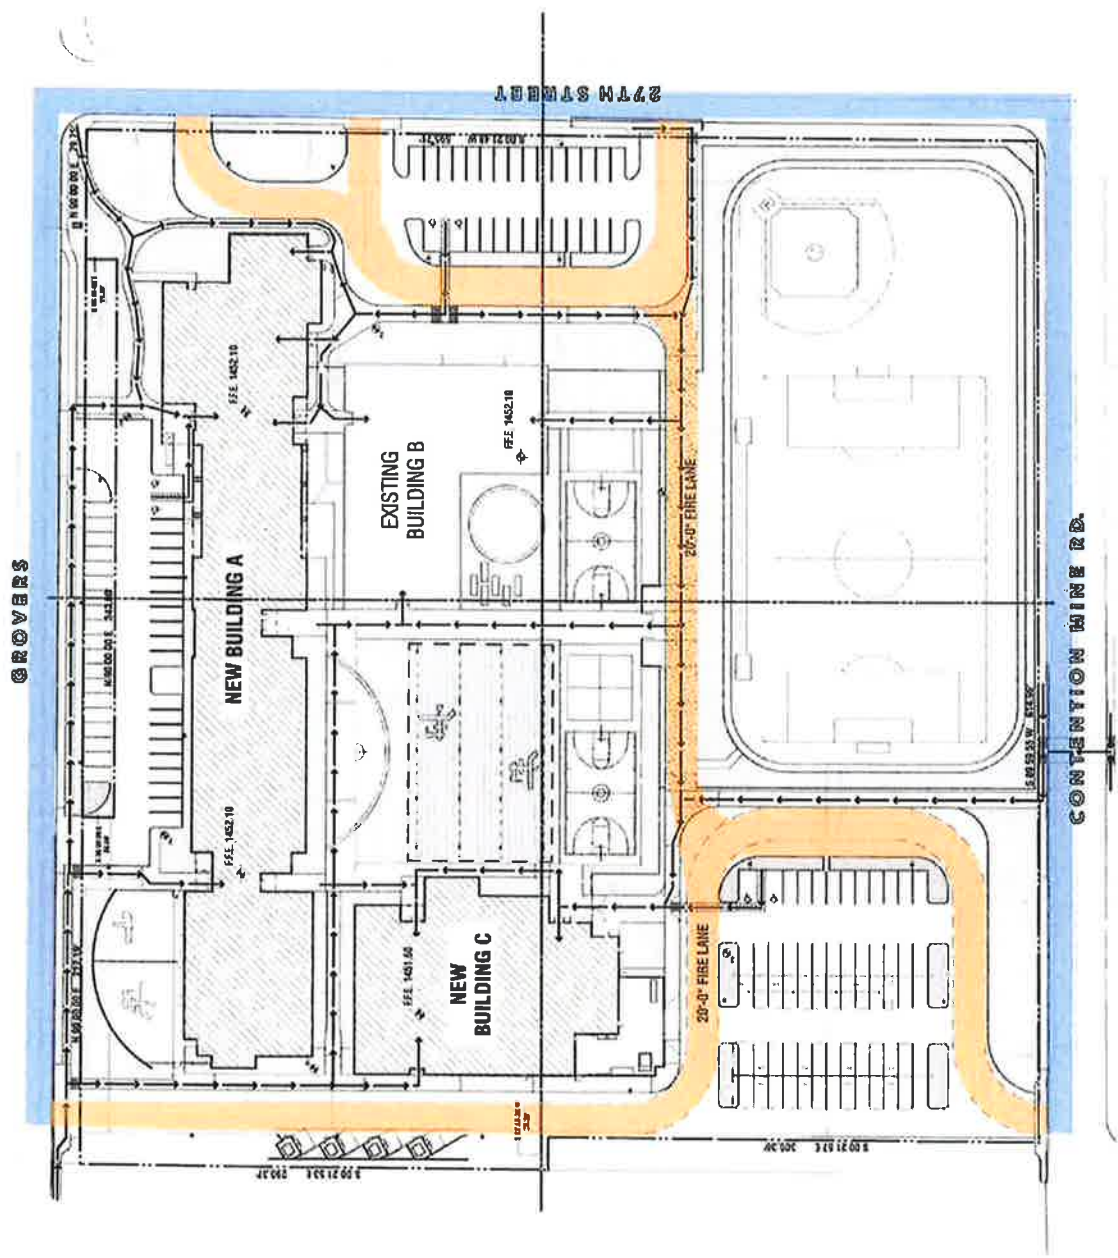

ARCHITECTURAL SITE PLAN