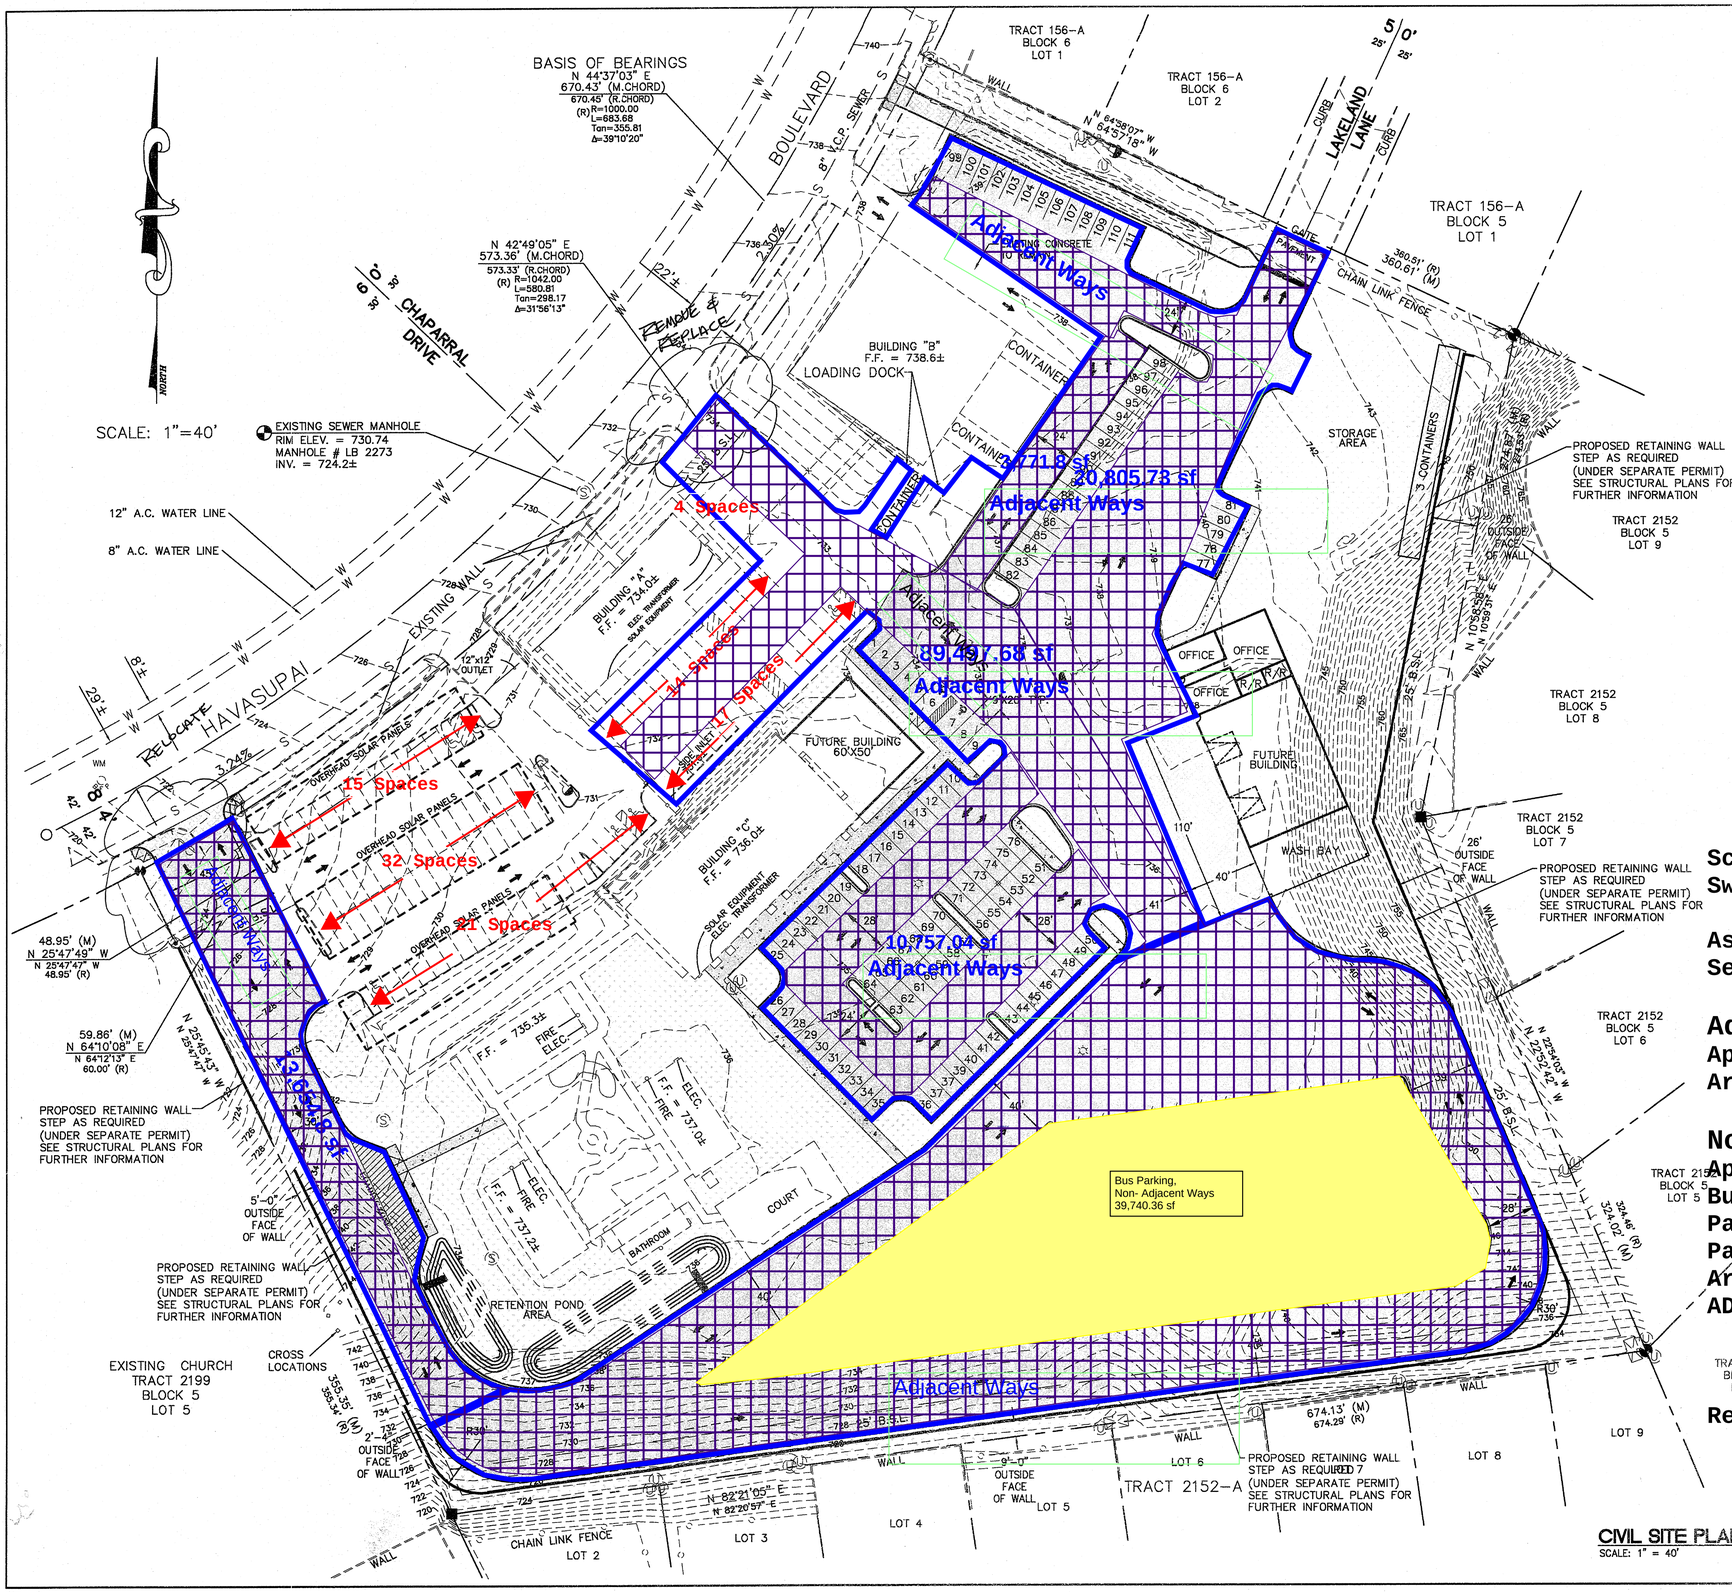

LEGEND

- FOUND CENTERLINE MONUMENT
- FOUND 1/2" REBAR, WITH CAP LS 9429
- FOUND 1/2" REBAR WITH FOUND CAP LS 11752
- FOUND 1/2" REBAR WITH CAP LS 11659
- FOUND 1/2" REBAR, NO CAP, SET CAP LS 32231
- FOUND PK NAIL WITH WASHER LS 32231
- INDICATES T.B.M. ASSUMED ELEVATION 100.0'
- EXISTING FIRE HYDRANT
- INDICATES LOCATION OF EXISTING SEWER CLEAN OUT
- INDICATES EXISTING WATER METER
- W — EXISTING WATER SERVICE
- SS — EXISTING SEWER SERVICE
- F.F. — PROPOSED FINISH FLOOR ELEVATION
- HDPE — PROPOSED HIGH DENSITY POLYETHYLENE PIPE
- 00 — EXISTING CONTOURS
- EXISTING EDGE OF PAVEMENT
- PROPOSED 6" M.A.G. CURB
- CB=1= — PROPOSED TOP OF CATCH BASIN ELEVATION
- INV= — PROPOSED INVERT ELEVATION
- TC= — PROPOSED TOP OF CURB ELEVATION
- C= — PROPOSED TOP OF CONCRETE ELEVATION
- TW= — PROPOSED TOP OF RETAINING WALL
- P= — PROPOSED TOP OF PAVEMENT ELEVATION
- FG= — PROPOSED FINISH GRADE ELEVATION
- PROPOSED RETAINING WALL (UNDER SEPARATE PERMIT)
- 00 — PROPOSED MASS GRADE CONTOURS
- PROPOSED PAVEMENT
- PROPOSED SIDEWALK
- PROPOSED CONCRETE
- PROPOSED LANDSCAPE

Scope:
Sweep area prior to any work.

Asphalt surface requiring Crack Seal and Seal-coat approximately (198,838 sf)

Adjacency ways
Approximately (119,975 sf) Seal-coat
Arrows (37)

Non-Adjacency ways
Approximately (78,864 sf) Seal-coat
Bus Parking (40)Striping and Numbering
Parking (207) Striping
Parking (25) Numbering
Arrows (2)
ADA Parking(7)

Revised 4/26/2023

REVIEWED FOR CODE COMPLIANCE
MAR 4 2015
BUILDING DIVISION LAKE HAVASU CITY

PLAN CHANGE & OFF-SITE DRIVEWAY

As Built
Prepared by Concord Companies, Inc.

CALL TWO WORKING DAYS BEFORE YOU DIG
602-263-1100
1-800-STAKE-IT
(OUTSIDE MARICOPA COUNTY)

REVISIONS	BY
REVISION 7/30/14	MD
REVISION 2/19/2015	MD

THESE DRAWINGS ARE PREPARED FOR THE EXCLUSIVE USE OF THE PROJECT IDENTIFIED ACROSS. A WRITTEN AUTHORIZATION FROM PROFESSIONAL ENGINEERING SERVICES, INC. IS REQUIRED FOR THE USE OF THESE DRAWINGS TO CONSTRUCT ON EACH ADDITIONAL SITE. ANY DUPLICATION OR ALTERATION OF THESE DRAWINGS WITHOUT OBTAINING A WRITTEN AUTHORIZATION FROM PROFESSIONAL ENGINEERING SERVICES, INC. CONSTITUTE A FRAUD AND SHALL BE SUBJECT TO LEGAL ACTION.

CLIENT: LAKE HAVASU SCHOOL DISTRICT
PROJECT: PARKING LOT EXPANSION
ADDRESS: 2200 HAVASUPAI BLVD. LAKE HAVASU CITY, ARIZONA TRACT 2152-A, BLOCK 1, LOT 1

PROFESSIONAL ENGINEERING SERVICES, INC.
2167 BIRCH SQUARE STE. A, LAKE HAVASU CITY, AZ 86403
WWW.AZPES.COM TEL: (928) 453-9955, FAX: (928) 453-9933

CERTIFICATE OF AUTHORIZATION
35906
N. GEORGE MITWASI
2/19/2015
REGISTERED PROFESSIONAL ENGINEER
ARIZONA, U.S.A.
EXPIRES: 3-31-2013

PREPARED BY: MD
CHECKED BY: NGM
DATE: 2/19/2015
SCALE: AS SHOWN
JOB NUMBER: PES131020

SHEET
C-2
2 OF 8